

MISSISSIPPI DEPARTMENT OF NATURAL RESOURCES

Bureau of Land and Water Resources

Southport Mall

P.O. Box 10631

Jackson, Mississippi 39209

WATER WELL DRILLERS LOG

HARRISON
G
2037

LYMAN well Co.

Harrison

10-24-85
date well completed

10-24-85
firm name

county well located

LANDOWNER: Don Clark
Rt. 13, Dorothy Lane
Gulfport, MS 39503
(mailing address)

description of formations encountered

from to

fine sand	0	40
blue clay	40	420
coarse sand	420	485
blue clay	485	603
coarse sand	603	623

WELL LOCATION:
sec. 21 T. 6 N. R. 11 E.
S. W.
3 miles from of Sunny
(distance) (direction) (nearest town)

WELL PURPOSE: household
(home, irrigation, municipal, industrial)

- WELL COMPLETION DATA:
- diameter (inches) 2
 - total depth (feet) 623
 - static water level (feet) 86 below above top of ground.
 - casing plastic 603
(material) (depth)
 - screen no if telescope see back.
(size)
 - screen 10ft 603
(length) (depth to top)
 - screen 2 P.V.C.
(size) (material)
 - pump 1 1/2 11
(HP) (yield gpm)
 - electric electric
(type power)
 - electric log no
(yes or no)
 - organization running log no
 - how well bottom plugged sand
shark


RECEIVED
APR 20 1986

Department of Natural Resources
Bureau of Land & Water Resources

DRILLERS REMARKS:

If well telescopes please sketch and show depths.

GROUND LEVEL

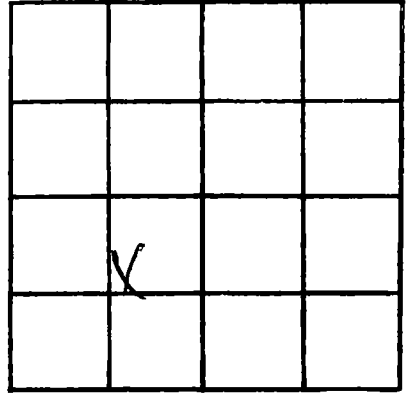

SECTION 21

Please indicate well location X.

ADDITIONAL INFORMATION

If more than one screen, show locations of each on sketch.