

MISSISSIPPI DEPARTMENT OF NATURAL RESOURCES

Bureau of Land and Water Resources

Southport Mall

P.O. Box 10631

Jackson, Mississippi 39209

WATER WELL DRILLERS LOG

Braden Pump and Well Service, Inc.

HARRISON

HARRISON
G
2039

2-13-

86

date well completed

firm name

county well located

LANDOWNER: MARLIN DUWHAM

RT5 BOX 122

GULFPORT, MS. 39503

(mailing address)

WELL LOCATION:

sec. 36 T. 6 S. R. 11 W.
3 1/2 miles E of Lyman
(distance) (direction) (nearest town)

WELL PURPOSE: Home
(home, irrigation, municipal, industrial)

WELL COMPLETION DATA:

(1) diameter (inches) 2"
(2) total depth (feet) 264
(3) static water level (feet) 15 below above top of ground.

(4) casing 2" Total (material) (depth)
2" (size) if telescope see back.

(5) screen 10" 244 (length) (depth to top)
2" PVC .008510 (size) (material)

(6) pump 1HP 10 (HP) (yield gpm)
230 10' TAIL PIPE (type power)

(7) electric log No (yes or no)

(organization running log)

(8) how well bottom plugged 2" PVC Sand Shark

description of formations encountered

from to

RED CLAY	0	40
SAND BROWN & WHITE	40	90
BLUE CLAY	90	230
SAND	230	264

DRILLERS REMARKS:


10' ET Tail pipe

RECEIVED
APR - 2 1986

Department of Natural Resources
Bureau of Land & Water Resources

If well telescopes please sketch and show depths.

GROUND LEVEL

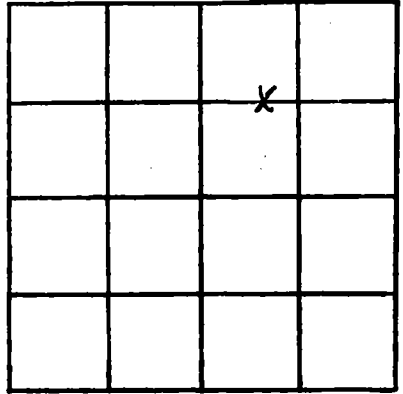

SECTION 36

Please indicate well location X.

ADDITIONAL INFORMATION

If more than one screen,
show locations of each on sketch.