

MISSISSIPPI DEPARTMENT OF NATURAL RESOURCES

Bureau of Land and Water Resources

Southport Mall

P.O. Box 10631

Jackson, Mississippi 39209

WATER WELL DRILLERS LOG

HARRISON  
G  
7040

2-25-86 19  
 date well completed

R J Mooka  
 firm name

HARRISLEY  
 county well located

LANDOWNER Charles F. Rye  
Kelly Street  
BIGBY RIVER ESTATES  
COLESPARK MS  
 (mailing address)

WELL LOCATION:  
 sec. 26 T. 6 N. R. 1 E  
2 1/2 miles W of Redwater  
 (distance) (direction) (nearest town)

WELL PURPOSE:  
 home irrigation,  municipal,  industrial

WELL COMPLETION DATA:

(1) diameter (inches) 2"

(2) total depth (feet) 720'

(3) static water level (feet) 50'  below top of ground,  above

(4) casing PVC, 720',  
 (material) (depth)  
 (size) if telescope see back.


(5) screen 10', 720'  
 (length) (depth to top)  
2", PVC  
 (size) (material)

(6) pump 1, 6  
 (HP) (yield gpm)  
E  
 (type power)

(7) electric log \_\_\_\_\_  
 (yes or no)  
 \_\_\_\_\_  
 (organization running log)

(8) how well bottom plugged Best

description of formations encountered	from	to
<u>TOP SOIL</u>	<u>0</u>	<u>10</u>
<u>Big sand &amp; clay</u>	<u>10</u>	<u>20</u>
<u>White clay</u>	<u>20</u>	<u>80</u>
<u>Blue clay</u>	<u>80</u>	<u>460</u>
<u>Thin sand</u>	<u>460</u>	<u>460</u>
<u>Blau clay</u>	<u>460</u>	<u>680</u>
<u>fine sand</u>	<u>680</u>	<u>700</u>
<u>Coarse sand</u>	<u>700</u>	<u>720</u>

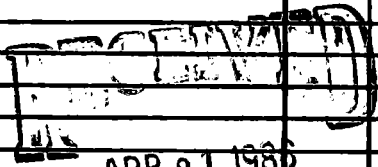


APR 21 1986

Department of Natural Resources  
 Bureau of Land & Water Resources

DRILLERS REMARKS: \_\_\_\_\_

If well telescopes please sketch and show depths.

GROUND LEVEL

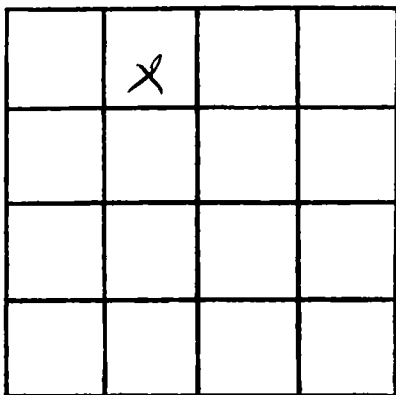

SECTION 36

Please indicate well location X.

ADDITIONAL INFORMATION

If more than one screen,  
show locations of each on sketch.