

MISSISSIPPI DEPARTMENT OF NATURAL RESOURCES

Bureau of Land and Water Resources

Southport Mall

P.O. Box 10631

Jackson, Mississippi 39209

WATER WELL DRILLERS LOG

COASTAL DISTRICT

SERVICE CODE

county well located

RT. 11, BOX 17

Oct 3, 1985

date well completed

19

Harrison

LANDOWNER:

Boots Builders

description of formations encountered

from

to

Shaw Road

top soil

1

10

Gulfport, Mo

(mailing address)

red clay

10

200

soft blue clay

200

450

hard blue clay

450

740

poor water sand

740

760

good water sand

760

775

WELL LOCATION:

sec 34 T 6 N S

R 11 E W

Shaw Road

(distance) (direction) (nearest town)

WELL PURPOSE:

home

(home, irrigation, municipal, industrial)

WELL COMPLETION DATA:

(1) diameter (inches) 4" x 2"

(2) total depth (feet) 775

(3) static water level (feet) 1.5 below top of ground

(4) casing PVC 760 (material) (depth)

4' x 2"

(size) If telescope see back.

(5) screen 15' 760 (length) (depth to top)

2" PVC (size) (material)

(6) pump 1 10 (HP) (yield gpm)

Etc. (type power)

(7) electric log no (yes or no)

(organization running log)

(8) how well bottom plugged 2" loose wash valves

DRILLERS REMARKS:

RECEIVED
MAY 19 1986

Department of Natural Resources
Bureau of Land & Water Resources

If well telescopes please sketch and show depths.


GROUND LEVEL

160' 4" pvc casing

615' 2" pvc casing

15' 2" pvc screen

2" BACK WASH valve

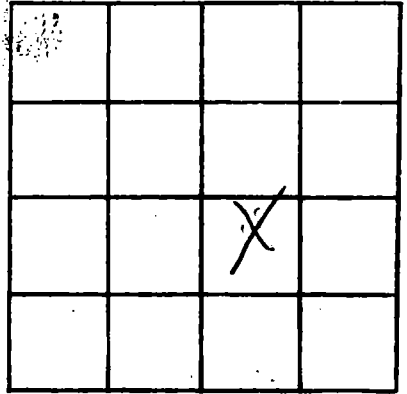

SECTION _____

Please indicate well location X.

ADDITIONAL INFORMATION

If more than one screen, show locations of each on sketch.