

MISSISSIPPI DEPARTMENT OF NATURAL RESOURCES

Bureau of Land and Water Resources

Southport Mall

P.O. Box 10631

Jackson, Mississippi 39209

WATER WELL DRILLERS LOG

HARRISON
G
2044

June 6-1986 date well completed
Mc Gill Pump & Well firm name
Harrison county well located


LANDOWNER: Benny Bowen
309 Harris Dr.
Shuffout Mo.
(mailing address)

WELL LOCATION:
sec. 30 T. 6 N. R. 11 E.
3 miles West of Shuffout
(distance) (direction) (nearest town)

WELL PURPOSE: home
(home, irrigation, municipal, industrial)

WELL COMPLETION DATA:
(1) diameter (inches) 2"
(2) total depth (feet) 520'
(3) static water level (feet) 98' below top of ground.
(4) casing PVC 510' (material) (depth)
2" (size) if telescope see back.
(5) screen 10' Bottom (length) (depth to top)
2" PVC (size) (material)
(6) pump 1 (HP) 7 (yield gpm)
Electric (type power)
(7) electric log NO (yes or no)
(organization running log)
(8) how well bottom plugged Seal

description of formations encountered	from	to
Mud	0	10
Sand	10	30
Mud	30	70
Sand	70	140
Mud	140	180
Sand	180	220
Mud	220	250
Sand	250	260
Mud	260	470
Sand	470	500

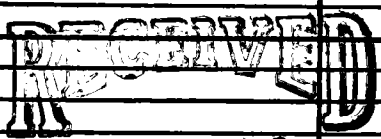


AUG 7 1986

Department of Natural Resources
Bureau of Land & Water Resources

DRILLERS REMARKS:

If well telescopes please sketch and show depths.

GROUND LEVEL

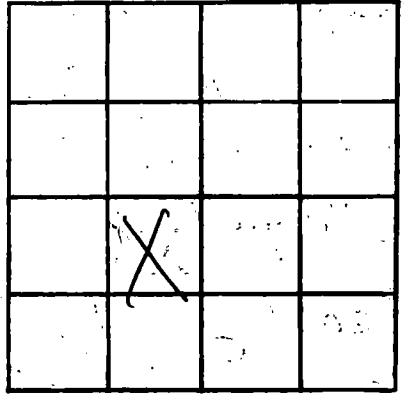

SECTION _____

Please indicate well location X.

ADDITIONAL INFORMATION

If more than one screen, show locations of each on sketch.