


If well telescopes please sketch and show depths.

GROUND LEVEL

525' 4" PVC
CASING

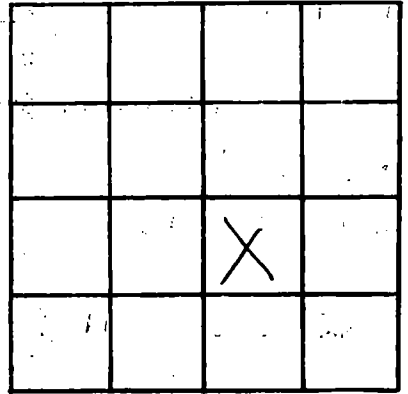

SECTION _____

Please indicate well location X.

ADDITIONAL INFORMATION

100' 2" PVC
CASING

20' 4" PVC
SCREEN

2" BACK
WASH VALVE

If more than one screen,
show locations of each on sketch.