

MISSISSIPPI DEPARTMENT OF NATURAL RESOURCES

Bureau of Land and Water Resources

Southport Mall

P.O. Box 10631

Jackson, Mississippi 39209

WATER WELL DRILLERS LOG
 COASTAL DRILLING & SERVICE CO.

RT. 11, BOX 81

BILOXI, MS 39532

Harrison
 county well located

Jackson
G
2047

10/3/60 19
 date well completed

LANDOWNER: Carl Robinson

description of formations encountered

from

to

1111 1/2 South St.

top soil

1 5

Franklin, MS
 (mailing address)

red clay

5 210

WELL LOCATION:

dark blue clay

210 250

sec. 9 T. 6 N. R. 11 E.
 S W

hard blue clay

250 350

fine water sand
 good water sand

350 410
 410 425

_____ miles _____ of _____
 (distance) (direction) (nearest town)

WELL PURPOSE: home
 (home, irrigation, municipal, industrial)

WELL COMPLETION DATA:

(1) diameter (inches) 4" x 2"

(2) total depth (feet) 425

(3) static water level (feet) 15 below
 top of ground.

(4) casing PVC, 409,
 (material) (depth)

4" x 2" If telescope see back.
 (size)

(5) screen 15', 409
 (length) (depth to top)

2" PVC
 (size) (material)

(6) pump 1 1/2 HP, 15
 (HP) (yield gpm)


etc.
 (type power)

(7) electric log no
 (yes or no)

(organization running log)

(8) how well bottom plugged 2" back
 wash valve

DRILLERS REMARKS:

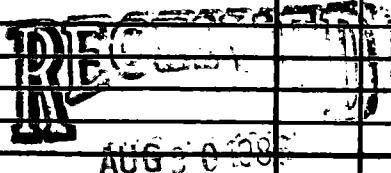

Department of Natural Resources
 Bureau of Land & Water Resources

If well telescopes please sketch and show depths.


GROUND LEVEL

180' 4" pvc casing

245' 2" pvc casing

15' 2" pvc screen

2" BACK WASH VALVE

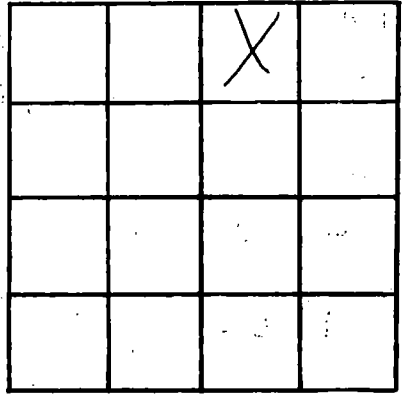

SECTION _____

Please indicate well location X.

ADDITIONAL INFORMATION

If more than one screen, show locations of each on sketch.