

MISSISSIPPI DEPARTMENT OF NATURAL RESOURCES

Bureau of Land and Water Resources

Southport Mall

P.O. Box 10631

Jackson, Mississippi 39209

WATER WELL DRILLERS LOG

Harrison
G 2050

3/18/86
date well completed

19 Lyman Well Co. Harrison
firm

county well located

LANDOWNERS

Fred Bryant
145 Crestview Dr.

description of formations encountered

from

to

Gpt 39503
(mailing address)

<u>Top soil</u>		<u>1'</u>	<u>1'</u>
<u>Sandy Clay</u>		<u>1'</u>	<u>15'</u>
<u>White Clay</u>		<u>15'</u>	<u>26'</u>
<u>Sand</u>		<u>26'</u>	<u>42'</u>
<u>Blue Clay</u>		<u>42'</u>	<u>135'</u>
<u>Sand</u>		<u>135'</u>	<u>147'</u>
<u>Blue Clay</u>		<u>147'</u>	<u>290'</u>
<u>Sand</u>		<u>290'</u>	<u>307'</u>
<u>Blue Clay</u>		<u>307'</u>	<u>530'</u>
<u>Sand</u>		<u>530'</u>	<u>580'</u>

WELL LOCATION:

sec. 6 T. 6 N. R. 11 E.
6 miles N of Gpt.
(distance) (direction) (nearest town)

WELL PURPOSE:

Home
(home, irrigation, municipal, industrial)

WELL COMPLETION DATA:

- (1) diameter (inches) 2"
- (2) total depth (feet) 550'
- (3) static water level (feet) 76' ^{below} top of ground
- (4) casing PVC, 540'
(material) (depth)
2" if telescope see back.
(size)
- (5) screen 10', 540'
(length) (depth to top)
2", PVC
(size) (material)
- (6) pump 1 8
(HP) (yield gpm)
electric
(type power)
- (7) electric log No
(yes or no)
No
(organization running log)
- (8) how well bottom plugged sand
shark

RECEIVED


OCT 14 1986

Department of Natural Resources
Bureau of Land & Water Resources

DRILLERS REMARKS:

If well telescopes please sketch and show depths.

GROUND LEVEL

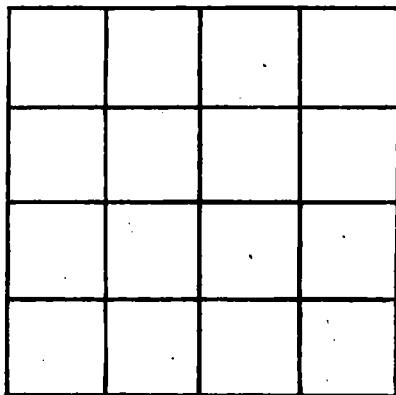

SECTION _____

Please indicate well location X.

ADDITIONAL INFORMATION

If more than one screen,
show locations of each on sketch.