

MISSISSIPPI DEPARTMENT OF NATURAL RESOURCES

Bureau of Land and Water Resources

Southport Mall

P.O. Box 10631

Jackson, Mississippi 39209

WATER WELL DRILLERS LOG

Harrison
G 2051

4/4/86 19 Lepman Well Co Harrison
date well completed firm name county well located

LANDOWNER: Dorothy Tidmore
Rt. 13, Box 389
Gpt 39503
(mailing address)

Description of formations encountered	from	to
<u>Topsoil</u>		<u>1"</u>
<u>Clay</u>	<u>15"</u>	<u>15"</u>
<u>Some white clay</u>	<u>15"</u>	<u>24"</u>
<u>Some</u>	<u>24"</u>	<u>38"</u>
<u>Blue clay</u>	<u>38"</u>	<u>125"</u>
<u>Some</u>	<u>127"</u>	<u>150"</u>

WELL LOCATION:
sec. 21 T. 6 N R. 11 E
9 miles W of Gulfport
(distance) (direction) (nearest town)

WELL PURPOSE:
(home, irrigation, municipal, industrial)

WELL COMPLETION DATA:

(1) diameter (inches) 2"

(2) total depth (feet) 150'

(3) static water level (feet) 30' below above top of ground.

(4) casing PVC 140'
(material) (depth)

2"
(size) If telescope see back.

(5) screen 10' 140'
(length) (depth to top)

2" PVC
(size) (material)

(6) pump 1 13
(HP) (yield gpm)

electric
(type power)

(7) electric log NO
(yes or no)

NO
(organization running log)

(8) how well bottom plugged sand
shark


RECEIVED
OCT 06 1986

Department of Natural Resources
Bureau of Land & Water Resources

DRILLERS REMARKS:

If well telescopes please sketch and show depths.

GROUND LEVEL

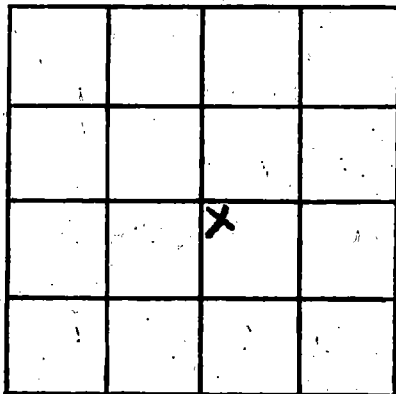

SECTION 21

Please indicate well location X.

ADDITIONAL INFORMATION

If more than one screen, show locations of each on sketch.