

MISSISSIPPI DEPARTMENT OF NATURAL RESOURCES

Bureau of Land and Water Resources

Southport Mall

P.O. Box 10631

Jackson, Mississippi 39209

WATER WELL DRILLERS LOG

Harrison  
G 2052

5/7/86 19 Lyman Well Co Harrison  
date well completed firm name county well located

LANDOWNER E.C. Cuendet  
Rt. 3, Box 714  
Lpt 39503  
(mailing address)

description of formations encountered	from	to
Top So.		1'
Sandy Clay	1'	7'
White Clay	7'	23'
Yellow Clay	23'	35'
Blue Clay	35'	189'
Fine Sand	189'	221'
Blue Clay	221'	345'
Fine sand	345'	354'
Blue Clay	354'	540'
Coarse Sand	540'	580'

WELL LOCATION:  
sec 1 T 6 N R 11 E  
8 miles North of Gulfport  
(distance) (direction) (nearest town)

WELL PURPOSE: Home  
(home, irrigation, municipal, industrial)

WELL COMPLETION DATA:

(1) diameter (inches) 4x2

(2) total depth (feet) 580'

(3) static water level (feet) 87' <sup>below</sup> above top of ground.

(4) casing PVC 560'  
(material) (depth)  
4x2 If telescope see back.  
(size)

(5) screen 20' 560'  
(length) (depth to top)  
2" PVC  
(size) (material)

(6) pump 1 18  
(HP) (yield gpm)  
electric  
(type power)

(7) electric log No  
(yes or no)  
No  
(organization running log)

(8) how well bottom plugged sand  
Shark

DRILLERS REMARKS:

RECEIVED


MAY 06 1986  
RECEIVED

Department of Natural Resources  
Bureau of Land & Water Resources  
661-A-1000

Department of Natural Resources  
Bureau of Land & Water Resources

If well telescopes please sketch and show depths.

GROUND LEVEL

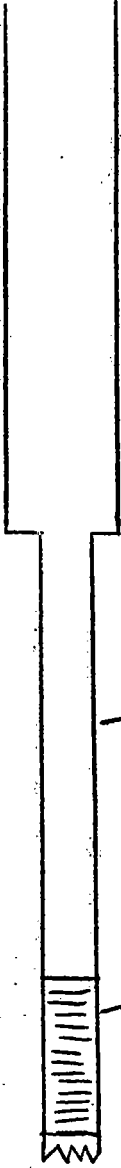

240'  
4" PVC

320'  
2" PVC

20'  
2" PVC  
screen

	X		

SECTION 31

Please indicate well location X.

ADDITIONAL INFORMATION

If more than one screen, show locations of each on sketch.