

MISSISSIPPI DEPARTMENT OF NATURAL RESOURCES

Bureau of Land and Water Resources

Southport Mall

P.O. Box 10631

Jackson, Mississippi 39209

WATER WELL DRILLERS LOG

HARRISON
G 2054

8/22/86
date well completed

Lyman Well
firm name

Harrison
county well located

LANDOWNER

D.W. Allan
01570 Beach Dr.
Gulfport, Md 39507
(mailing address)

description of formations encountered

from

to

<u>Topsail</u>		<u>1"</u>	<u>1"</u>
<u>Sandy Clay</u>		<u>13"</u>	<u>13"</u>
<u>Sand</u>		<u>24"</u>	<u>24"</u>
<u>White & Yellow Clay</u>		<u>29"</u>	<u>29"</u>
<u>Gray Clay</u>		<u>39"</u>	<u>39"</u>
<u>Sand</u>		<u>85"</u>	<u>40"</u>
<u>Blue Clay</u>		<u>110"</u>	<u>178"</u>
<u>Sand</u>		<u>118"</u>	<u>195"</u>


WELL LOCATION:

sec. 20 T. 16 N. R. 11 E.
12 miles North of Gulfport
(distance) (direction) (nearest town)

WELL PURPOSE: Home
(home, irrigation, municipal, industrial)

WELL COMPLETION DATA:

- (1) diameter (inches) 2"
- (2) total depth (feet) 195'
- (3) static water level (feet) 44' below top of ground.
- (4) casing PVC, 125'
(material) (depth)
2" If telescope see back.
(size)
- (5) screen 10', 185'
(length) (depth to top)
2", PVC
(size) (material)
- (6) pump 1 electric
(HP) (yield gpm) (type power)
- (7) electric log NO
(yes or no)
NO
(organization running log)
- (8) how well bottom plugged sand
Shark

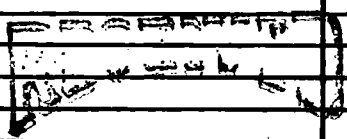


Aug 28 1986

Department of Natural Resources
Bureau of Land & Water Resources

DRILLERS REMARKS: None

If well telescopes please sketch and show depths.

GROUND LEVEL

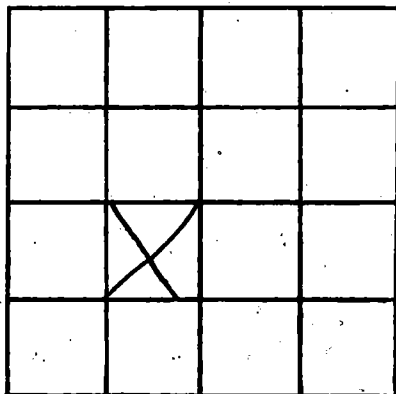

SECTION 20

Please indicate well location X.

ADDITIONAL INFORMATION

If more than one screen, show locations of each on sketch.