

# MISSISSIPPI DEPARTMENT OF NATURAL RESOURCES

Bureau of Land and Water Resources

COUNTY WELL LOCATED  
**Harrison**

WELL NUMBER CODED  
**G 2063**

DATE WELL COMPLETED  
**5/30/87**

PERMIT NUMBER

NAME OF DRILLING FIRM  
**Lyman Well Co.**

P.O. Box 10631  
Jackson, Mississippi 39209  
WATER WELL DRILLERS LOG

NAME & MAILING ADDRESS OF LANDOWNER  
**Pete Moss**

**Rt. 11, Box 290**

**Gulfport, Miss 39503**

WELL LOCATION SEC TOWNSHIP RANGE  
**21 6 N 11 E**

DISTANCE DIRECTION NEAREST TOWN  
**9 Miles North of Gulfport**

OTHER LANDMARK

WELL PURPOSE: Home, Irrigation, Municipal, Industrial, Fish Pond, etc.  
**Home**

**PUMP DATA**

PUMP TYPE (Circle One):  
**Submersible**, Turbine, Jet, Flowing Well, Other (Describe)

POWER TYPE (Circle One):  
**Electric**, Tractor, Diesel, Gasoline, Butane, Other (Describe)

Pump Capacity (GPM) <b>18</b>	No. of Stages <b>8</b>	Setting Depth <b>120'</b>	FT.
----------------------------------	---------------------------	------------------------------	-----

PUMP TEST

Well yielded \_\_\_\_\_ GPM with a drawdown of \_\_\_\_\_ ft. after \_\_\_\_\_ hours of pumping

**WELL DATA**

Well Depth <b>612'</b>	Casing Diameter (In.) <b>4 X 2</b>	Casing Length (Ft.) <b>592'</b>
Type of Casing <b>PVC</b>	Hole Depth <b>612'</b>	Depth to Static Water Level <b>83'</b>

TYPE OF COMPLETION: (Circle One or More):  
**Natural Development**, Gravel Packed, Underreamed, Telescoped, Open Hole, Other

Top of Lap Pipe or Reduction in Casing  
**232' FEET** IF TELESKOPED OR MORE THAN ONE SCREEN: USE BACK PAGE

**LOG DATA**

TYPE OF LOG RUN (Circle One):  
**No Log Run**, Electric, Gamma Ray, Density, Sonic, Neutron, Other (Describe)

Name of Organization Running Log

**SCREEN DATA**

Diameter - Inches <b>2"</b>	Length - Feet <b>20'</b>	Slot Size - Inches
Screen Type <b>PVC sawed</b>	Depth to Bottom - Feet <b>612'</b>	

**GEOLOGIC DATA (Office Use Only)**

Surface Elev.	Geologic Unit	Unit Thickness	Depth to Top
Subs. SWL	Date	Analysis	Aquifer Test

Driller's Remarks  
**None**

DESCRIPTION OF FORMATIONS ENCOUNTERED	FROM	TO	GEOLOGIC UNIT	FROM	TO
<b>Lipsal</b>		<b>1'</b>			
<b>Sandy yellow &amp; white clay</b>	<b>1'</b>	<b>23"</b>			
<b>Sandy blue clay</b>	<b>23"</b>	<b>38"</b>			
<b>Blue clay</b>	<b>38"</b>	<b>206"</b>			
<b>Sandy loam</b>	<b>206"</b>	<b>252"</b>			
<b>Blue clay</b>	<b>252"</b>	<b>283"</b>			
<b>Sand &amp; silt</b>	<b>283"</b>	<b>409"</b>			
<b>Blue clay</b>	<b>409"</b>	<b>586"</b>			
<b>Sand</b>	<b>586"</b>	<b>612"</b>			



RECEIVED

AUG 25 1987

**Department of Natural Resources  
Bureau of Land & Water Resources**

IF MORE SPACE IS NEEDED, USE BACK

If well telescopes please sketch and show depths.

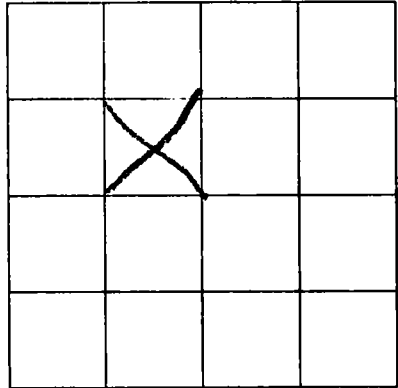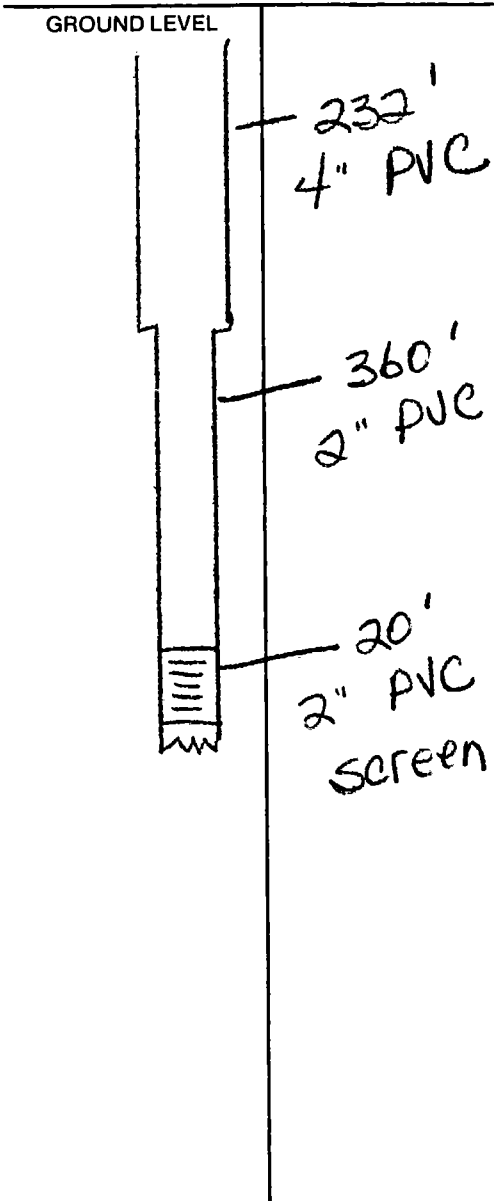

SECTION 21

Please indicate well location X.

ADDITIONAL INFORMATION

Lined area for additional information.

If more than one screen, show location of each on sketch.