

MISSISSIPPI DEPARTMENT OF NATURAL RESOURCES
Bureau of Land and Water Resources

P.O. Box 10631

Jackson, Mississippi 39209

WATER WELL DRILLERS LOG

COUNTY WELL LOCATED Carrison	
WELL NUMBER G 2064	CODED
DATE WELL COMPLETED Aug 25-87	

PERMIT NUMBER
NAME OF DRILLING FIRM 0239

NAME & MAILING ADDRESS OF LANDOWNER James Costom 650 Schogan Dr. Gpt. MS.			
WELL LOCATION:	SEC 25	TOWNSHIP 6^N	RANGE 11^E
DISTANCE 3 Miles	DIRECTION WEST	NEAREST TOWN Lyman	
OTHER LANDMARK			
WELL PURPOSE <input checked="" type="radio"/> Home, <input type="radio"/> Irrigation, <input type="radio"/> Municipal, <input type="radio"/> Industrial, <input type="radio"/> Fish Pond, etc.			

PUMP DATA			
PUMP TYPE (Circle One): <input checked="" type="radio"/> Submersible, <input type="radio"/> Turbine, <input type="radio"/> Jet <input type="radio"/> Flowing Well, Other (Describe)			
POWER TYPE (Circle One): <input checked="" type="radio"/> Electric, <input type="radio"/> Tractor, <input type="radio"/> Diesel, <input type="radio"/> Gasoline, <input type="radio"/> Butane, Other (Describe)			
Pump Capacity (GPM) 18	No. of Stages	Setting Depth 126' FT.	
PUMP TEST			
Well yielded 18 GPM with a drawdown of 10 ft. after 1 hours of pumping			

WELL DATA		
Well Depth 500	Casing Diameter (In.) 4" X 2"	Casing Length (Ft.) 500 20
Type of Casing PVC	Hole Depth 500	Depth to Static Water Level 80'
TYPE OF COMPLETION: (Circle One or More): <input checked="" type="radio"/> Gravel Packed, <input type="radio"/> Underreamed, <input type="radio"/> Telescoped, <input checked="" type="radio"/> Natural Development, <input type="radio"/> Open Hole, <input type="radio"/> Other (Describe)		
Top of Lap Pipe or Reduction in Casing FEET <input type="checkbox"/> IF TELESCOPED OR MORE THAN ONE SCREEN: USE BACK PAGE		

LOG DATA	
TYPE OF LOG RUN (Circle One): <input checked="" type="radio"/> No Log Run, <input type="radio"/> Electric, <input type="radio"/> Gamma Ray, <input type="radio"/> Density, <input type="radio"/> Sonic, <input type="radio"/> Neutron, Other (Describe)	
Name of Organization Running Log	

SCREEN DATA		
Diameter - Inches 2"	Length - Feet 20'	Slot Size - Inches 0.006
Screen Type PVC		Depth to Bottom - Feet 500'

GEOLOGIC DATA (Office Use Only)			
Surface Elev.	Geologic Unit	Unit Thickness	Depth to Top
Subs. SWL	Date	Analysis	Aquifer Test
Driller's Remarks			

DESCRIPTION OF FORMATIONS ENCOUNTERED	FROM	TO	FORMATION ENCOUNTERED	FROM	TO
mud	0	140			
sand	140	160			
mud	160	170			
sand	170	240			
mud	240	440			
sand	440	500			

RECEIVED


OCT 14 1987

Department of Natural Resources
Bureau of Land & Water Resources

IF MORE SPACE IS NEEDED, USE BACK

If well telescopes please
sketch and show depths.

GROUND LEVEL

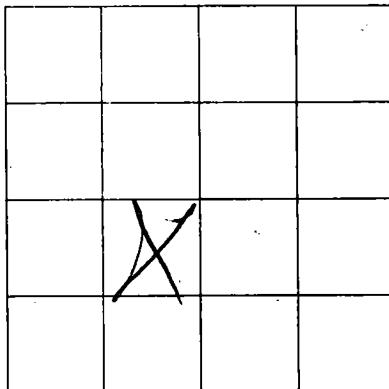

SECTION _____

Please indicate well location X.

ADDITIONAL INFORMATION

Lined area for providing additional information.

If more than one screen,
show location of each on sketch.