

MISSISSIPPI DEPARTMENT OF NATURAL RESOURCES

Bureau of Land and Water Resources

Southport Mall

P.O. Box 10631

Jackson, Mississippi 39209

WATER WELL DRILLERS LOG

HARRISON  
G 2065

6-19-87 19  
date well completed

P. J. Mahe  
firm name

HARRISON  
county well located

LANDOWNER: DAV DAVIS  
NORTH SW 1/4 RD  
Lynn, MS  
(mailing address)

description of formations encountered	from	to
<u>TOP SOIL</u>	<u>0</u>	<u>20</u>
<u>white clay</u>	<u>20</u>	<u>80</u>
<u>blue clay</u>	<u>80</u>	<u>240</u>
<u>Fine Sand</u>	<u>240</u>	<u>260</u>
<u>blue clay</u>	<u>260</u>	<u>440</u>
<u>fine sand</u>	<u>440</u>	<u>460</u>
<u>med sand</u>	<u>460</u>	<u>480</u>
<u>Coarse Sand</u>	<u>480</u>	<u>500</u>

WELL LOCATION:  
sec. 27 T. 6 N. R. 11 E  
2 miles E of Lynn  
(distance) (direction) (nearest town)

WELL PURPOSE:  
(home, irrigation, municipal, industrial)

WELL COMPLETION DATA:

(1) diameter (inches) 2"

(2) total depth (feet) 500'

(3) static water level (feet) 20' below top of ground.

(4) casing PVC, 500'  
(material) (depth)  
         if telescope see back.  
(size)

(5) screen 10', 500'  
(length) (depth to top)  
2", PVC  
(size) (material)

(6) pump 1, 6  
(HP) (yield gpm)  
E  
(type power)

(7) electric log           
(yes or no)  
          
(organization running log)

(8) how well bottom plugged         

DRILLERS REMARKS:


**RECEIVED**

NOV 04 1987

Department of Natural Resources  
Bureau of Land & Water Resources

If well telescopes please sketch and show depths.

GROUND LEVEL

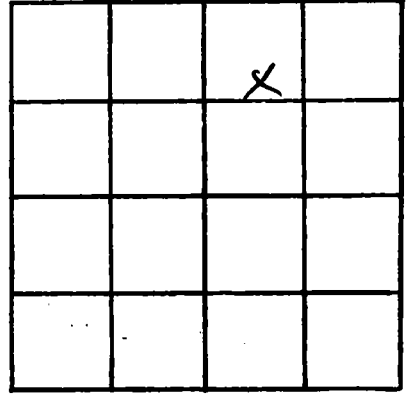

SECTION 27

Please indicate well location X.

ADDITIONAL INFORMATION

If more than one screen,  
show locations of each on sketch.