

MISSISSIPPI DEPARTMENT OF NATURAL RESOURCES

Bureau of Land and Water Resources

P.O. Box 10631

Jackson, Mississippi 39209

WATER WELL DRILLERS LOG

COUNTY WELL LOCATED HARRISON	
WELL NUMBER G	CODED
2093	
DATE WELL COMPLETED 5-04-90	

PERMIT NUMBER 0-239
NAME OF DRILLING FIRM McGee

NAME & MAILING ADDRESS OF LANDOWNER Braden		
Marie Rd.		
Meat, Ms.		
WELL LOCATION: SEC	TOWNSHIP	RANGE
26	6	N 11 E
DISTANCE	DIRECTION	NEAREST TOWN
8 Miles	North of	Opt.
OTHER LANDMARK		
WELL PURPOSE: <input checked="" type="radio"/> Home, <input type="radio"/> Irrigation, <input type="radio"/> Municipal, <input type="radio"/> Industrial, <input type="radio"/> Fish Pond, etc.		

PUMP DATA		
PUMP TYPE (Circle One): Submersible, Turbine, <input checked="" type="radio"/> Jet, Flowing Well, Other (Describe) _____		
POWER TYPE (Circle One): <input checked="" type="radio"/> Electric, <input type="radio"/> Tractor, <input type="radio"/> Diesel, <input type="radio"/> Gasoline, <input type="radio"/> Butane, Other (Describe) _____		
Pump Capacity (GPM) 15	No. of Stages 2	Setting Depth _____ FT.
PUMP TEST		
Well yielded _____ GPM with a drawdown of _____ ft. after 1 hours of pumping		


WELL DATA		
Well Depth 520'	Casing Diameter (In.) 2"	Casing Length (Ft.) 510'
Type of Casing PUC	Hole Depth 520'	Depth to Static Water Level
TYPE OF COMPLETION: (Circle One or More): Gravel Packed, Underreamed, Telescoped, <input checked="" type="radio"/> Natural Development, <input type="radio"/> Open Hole, <input type="radio"/> Other (Describe) _____		
Top of Lap Pipe or Reduction in Casing		
FEET		
IF TELESCOPED OR MORE THAN ONE SCREEN: USE BACK PAGE		

LOG DATA	
TYPE OF LOG RUN (Circle One): Electric, Gamma Ray, Density, Sonic, <input checked="" type="radio"/> Neutron, Other (Describe) _____	
Name of Organization Running Log	

SCREEN DATA		
Diameter - Inches 2"	Length - Feet 10'	Slot Size - Inches .0006
Screen Type Sch 40 puc	Depth to Bottom - Feet 520'	

GEOLOGIC DATA (Office Use Only)			
Surface Elev.	Geologic Unit	Unit Thickness	Depth to Top
Subs. SWL	Date	Analysis	Aquifer Test
Driller's Remarks			

DESCRIPTION OF FORMATIONS ENCOUNTERED	FROM	TO
SAND	0	40
MUD	40	100
MUD, SAND	100	120
SAND	120	140
MUD	140	240
MUD, SAND	240	300
MUD	300	440
MUD, SAND	440	500
SAND	500	520

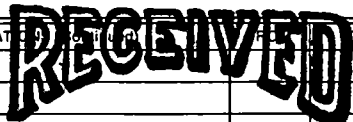


DEC 02 1991

**Dept. of Environmental Quality
Bureau of Land & Water Resources**

IF MORE SPACE IS NEEDED, USE BACK

If well telescopes please sketch and show depths.

GROUND LEVEL

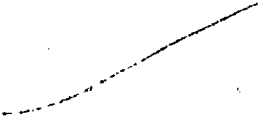


	A		

SECTION _____

Please indicate well location X.

ADDITIONAL INFORMATION

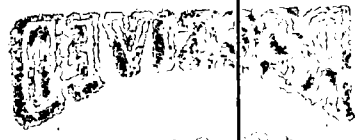

3000
1950
2000
2100
2200
2300
2400
2500
2600
2700
2800
2900
3000

If more than one screen, show location of each on sketch.