

HAR.

MISSISSIPPI BOARD OF WATER COMMISSIONERS

G 2107 #L 6 219808  
7-23-63

WATER WELL DRILLERS LOG

C. T. SWITZER WELL CO.

Date: 7/23, 1963, Driller: [Signature], County: Harrison

(Name)

(1) Owner of Land: E. A. Murphy, Jr.  
(Name)

484 Duckworth Rd, Nuyent  
(Address)

(2) Location: 1/4, 1/4, Sec. 6 R 11  
1/2 miles S, of Hughes act.  
(distance) (direction) (Nearest Town)

(3) Topography: [check] (Hilly) (Flat) (Level)

(4) Purpose of Well: Domestic  
(Domestic Irrigation, Municipal, Industrial, Other)

Description & Color of Materials Sand, Clay, Red Clay, Shell, etc.	Thick- ness Feet	Depth Feet
Clay	20	22
Clay w/ sand & sh	22	45
sand	45	66
Clay	66	152
sand & sh	152	171
Clay shale	171	192
Clay	192	256
sand, sh	256	298
Clay sand & sh	298	298
Clay	298	314
sand	314	320
Clay	320	374
sand, fine	374	384
sand, sh	384	406
sand, fine	406	430
Clay	430	440
sand	440	494
Sub at 484'		

Information upon completion of well:

(1) Diameter 3 1/2 inches.

(2) Total Depth 484 feet.

(3) Water Level 42' feet below top of ground.

(4) Cased to 484', Size 3 1/2"


(5) Screen: Size 2", Length 10'

(6) Were any formations sealed against pollution?  
[check] yes, [ ] no.

If YES depth of formation


Why Health Dept requirement

Drillers Remarks:

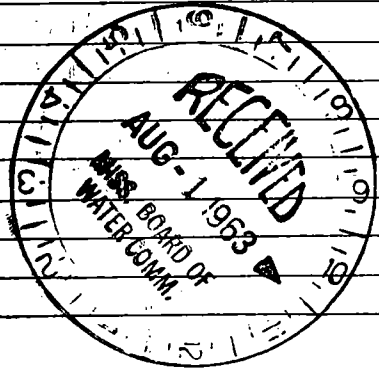

(Use Back Side)

Well No.

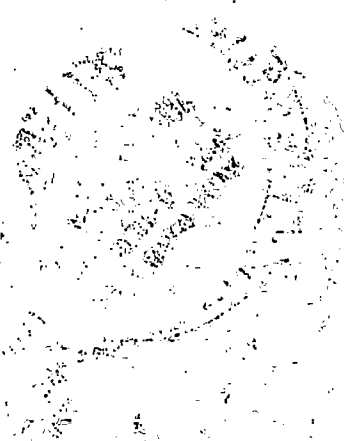

*John W. ...*

*10/10*  
*1891*