

CODED

HARRISON

MISSISSIPPI
BOARD OF WATER COMMISSIONERS
416 North State Street
Jackson, Mississippi 39201

WATER WELL DRILLERS LOG

~~_____~~
 HI
 3-21-69

March 21 1969 L. L. Garland W. W. Jackson
 date well completed firm name county well located

LANDOWNER: Joseph R. Bryant
 Rt. 1 Box 327

description of formations encountered from to

Ocean Springs, Miss
 (mailing address)

WELL LOCATION:
 sec. 5 T. 1 S. R. 9 E. S. 1 W. 2
 8 miles N.W. of Rd.
 (distance) (direction) (nearest town)

WELL PURPOSE: Home
 (home, irrigation, municipal, industrial)

WELL COMPLETION DATA:

- (1) diameter (inches) 2
- (2) total depth (feet) 262
- (3) static water level (feet) 39 ^{below} _{above} top of ground.
- (4) casing steel, 252,
 (material) (depth),
2"
 (size) If telescope see back.
- (5) screen 10 ft., 252,
 (length) (depth to top)
8 gauge, 2", steel
 (size) (material)
- (6) pump 1/2 252 gal per
 (HP) (yield gpm) 1/2.
- electric
 (type power)
- (7) electric log _____
 (yes or no)

 (organization running log)

(8) how well bottom plugged B. W. Velaz

DRILLERS REMARKS:
20 ft water
leaving sand


CODED

MAR 27 1969
 MISS. ED. CE
 MISSISSIPPI

If well telescopes please sketch and show depths.

GROUND LEVEL

02/02/20

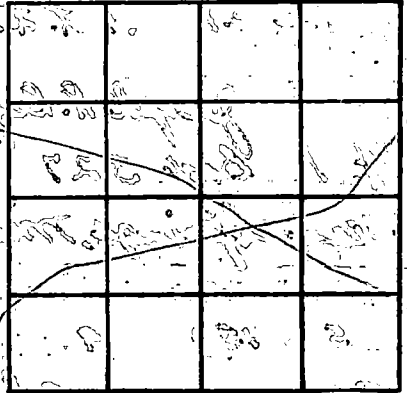

SECTION _____

Please indicate well location X.

ADDITIONAL INFORMATION

If more than one screen, show locations of each on sketch.