

HAR.

H 4
7-26-62

WATER WELL DRILLERS LOG

303 E

Date: July 26, 1962, Driller: Herb Drilling Co. **CODED** Harrison

(1) Owner of Land: W.H.F. Trochesset
(Name)
B.R. Biloxi, Miss.
(Address)

(2) Location: NW 1/4, SW 1/4, Sec. 9 (SW/4)
on Highway 67
13 miles N.W. of Biloxi
(distance) (direction) (Nearest Town)

(3) Topography: Hilly
(Hilly) (Flat) (Level)

(4) Purpose of Well: Domestic
(Domestic Irrigation
Municipal, Industrial, Other)

Description & Color of Materials Sand, Clay, Red Clay, Shell, etc.	Thick- ness Feet	Depth Feet
Clay	15	15
Sand	21	36
Black clay	12	48
White Clay	10	58
Blue Clay	225	275
Fine Grey Sand	35	410
Medium Sand	25	435
Coarse Sand	21	456
Medium Sand 456 on ?		

Information upon completion of well:

(1) Diameter 2 inches.

(2) Total Depth 451 feet.

(3) Water Level 86 feet below top of ground.

(4) Cased to 441, Size 2"

(5) Screen: Size 2" 8/16, Length 10 FT.

(6) Were any formations sealed against pollution?


_____ yes, _____ no.

If YES depth of formation _____

Why _____

Drillers Remarks: _____

CODED

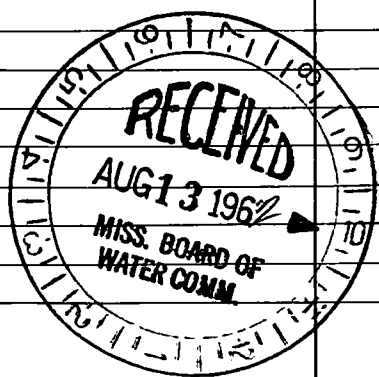

(Use Back Side)

Well No.

