

HAR.

H11

WATER WELL DRILLERS LOG = G - 308

7-25-60

Date: 7-25, 1960, Driller: Joseph M. Miller County Harrison (Name)

(1) Owner of Land: L.V. Marie  
 (Name)  
RR# Box 156 - Safford,  
 (Address)

(2) Location: 1/4, 1/4, Sec.     T     R      
10 miles NE, of Safford  
 (distance) (direction) (Nearest Town)

(3) Topography: Hilly  
 (Hilly) (Flat) (Level)

(4) Purpose of Well: Domestic  
 (Domestic Irrigation  
 Municipal, Industrial, Other)

| Description & Color of Materials<br>Sand, Clay, Red Clay, Shell, etc. | Thick-<br>ness<br>Feet | Depth<br>Feet |
|---|------------------------|---------------|
| Surface Soil & Sand.  | 12                     | 12            |
| Hard. Brown Clay.   | 9                      | 21            |
| Br. Clay.   | 9                      | 31            |
| Blue Clay.  | 14                     | 45            |
| Blk Clay, Wood Sand.  | 31                     | 76            |
| Wd Clay, Blue Clay.   | 34                     | 110           |
| Break in Lt.  | 9                      | 119           |
| Fine Brown Sand.  | 11                     | 130           |
| Brown Sand  | 11                     | 141           |
| " " "   | 44                     | 185           |

Information upon completion of well:

(1) Diameter 2 inches.

(2) Total Depth 180 feet.

(3) Water Level 38 feet below top of ground.

(4) Cased to 174', Size 2"

(5) Screen: Size 2', Length 6'

(6) Were any formations sealed against pollution?  
    yes,     no.

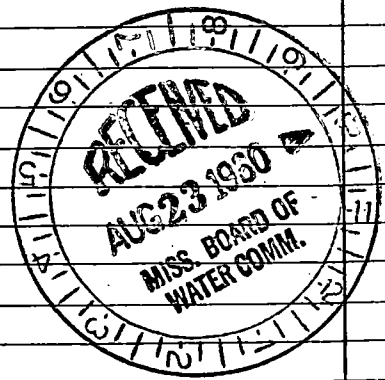
If YES depth of formation    

Why    

Drillers Remarks:    



0024

(Use Back Side)

Well No.

vin

3 miles

no more

Three Rivers Rd,

49

Hyman

53