

H.A.R.

H

WATER WELL DRILLERS LOG

?

6-5-61

Date: JUN 5 1961, Driller: C. T. SWITZER WELL CO. County Harrison

(Name)

(1) Owner of Land: James Martin (Name)

(Address)

(2) Location: 1/4, 1/4, Sec. T R, miles (distance) of (direction) (Nearest Town)

(3) Topography: X (Hilly) (Flat) (Level)

(4) Purpose of Well: Domestic (Domestic Irrigation, Municipal, Industrial, Other)

Information upon completion of well:

(1) Diameter 2 inches.

(2) Total Depth 766 feet.

(3) Water Level 1' + feet below top of ground.

(4) Cased to 766, Size 2 inches.

(5) Screen: Size 2 inches, Length 30 inches.

(6) Were any formations sealed against pollution?

X yes, no.

If YES depth of formation

Why Health Dept Requirement


Drillers Remarks:

Description & Color of Materials Sand, Clay, Red Clay, Shell, etc.

Thickness Feet

Depth Feet

Table with 3 columns: Description & Color of Materials, Thickness Feet, Depth Feet. Rows contain geological data such as clay, sand, shale, and streak.

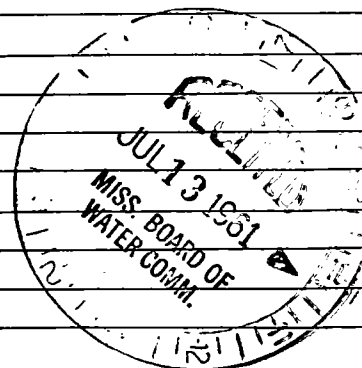

Well No.

(Use Back Side)

