

HAR.

H15

1-28-63

WATER WELL DRILLERS LOG

CODED

Date: Jan 28, 1963, Driller: Joe Miller County Tarrison
(Name)

(1) Owner of Land: M. Miles
(Name)
RR# Beloit Miss
(Address)

(2) Location: NE 1/4, SW 1/4, Sec. 37 T. 10 R. 10
15 miles North East, of Suffolk
(distance) (direction) (Nearest Town)

(3) Topography: Flat
(Hilly) (Flat) (Level)

(4) Purpose of Well: Domestic
(Domestic Irrigation) (Municipal, Industrial, Other)

| Description & Color of Materials Sand, Clay, Red Clay, Shell, etc. | Thick- ness Feet | Depth Feet |
|-----------------------------------------------------------------------|------------------------|---------------|
| Surface | 8 | 8 |
| White sand | 14 | 22 |
| Red sand & Red Clay | 2/8 | 70 |
| White Clay | 10 | 80 |
| Blue Clay | 142 | 222 |
| Small Bricks & Clay | 29 | 251 |
| Hard Blue Clay | 117 | 368 |
| Clay & sand Bricks (N&S) | 94 | 462 |
| Red sand Fine | 30 | 492 |
| Red Blue Clay | 2 | 494 |
| Red sand (Better) | 12 | 506 |
| Red Sand Fine | 17 | 523 |
| Hard Blue Clay | | 526 |

Information upon completion of well:

(1) Diameter 2" inches.

(2) Total Depth 526' feet.

(3) Water Level 18' feet below top of ground.

(4) Cased to 513', Size 2"

(5) Screen: Size 2', Length 10'


(6) Were any formations sealed against pollution?
_____ yes, _____ no.

If YES depth of formation _____

Why _____

Drillers Remarks: _____


CODED

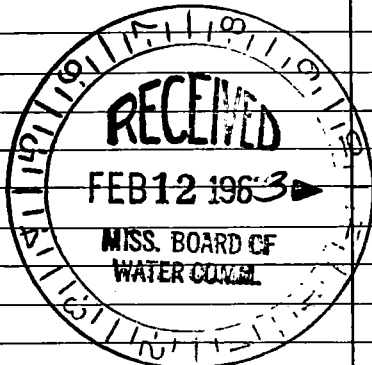

over

(Use Back Side)

Well No.

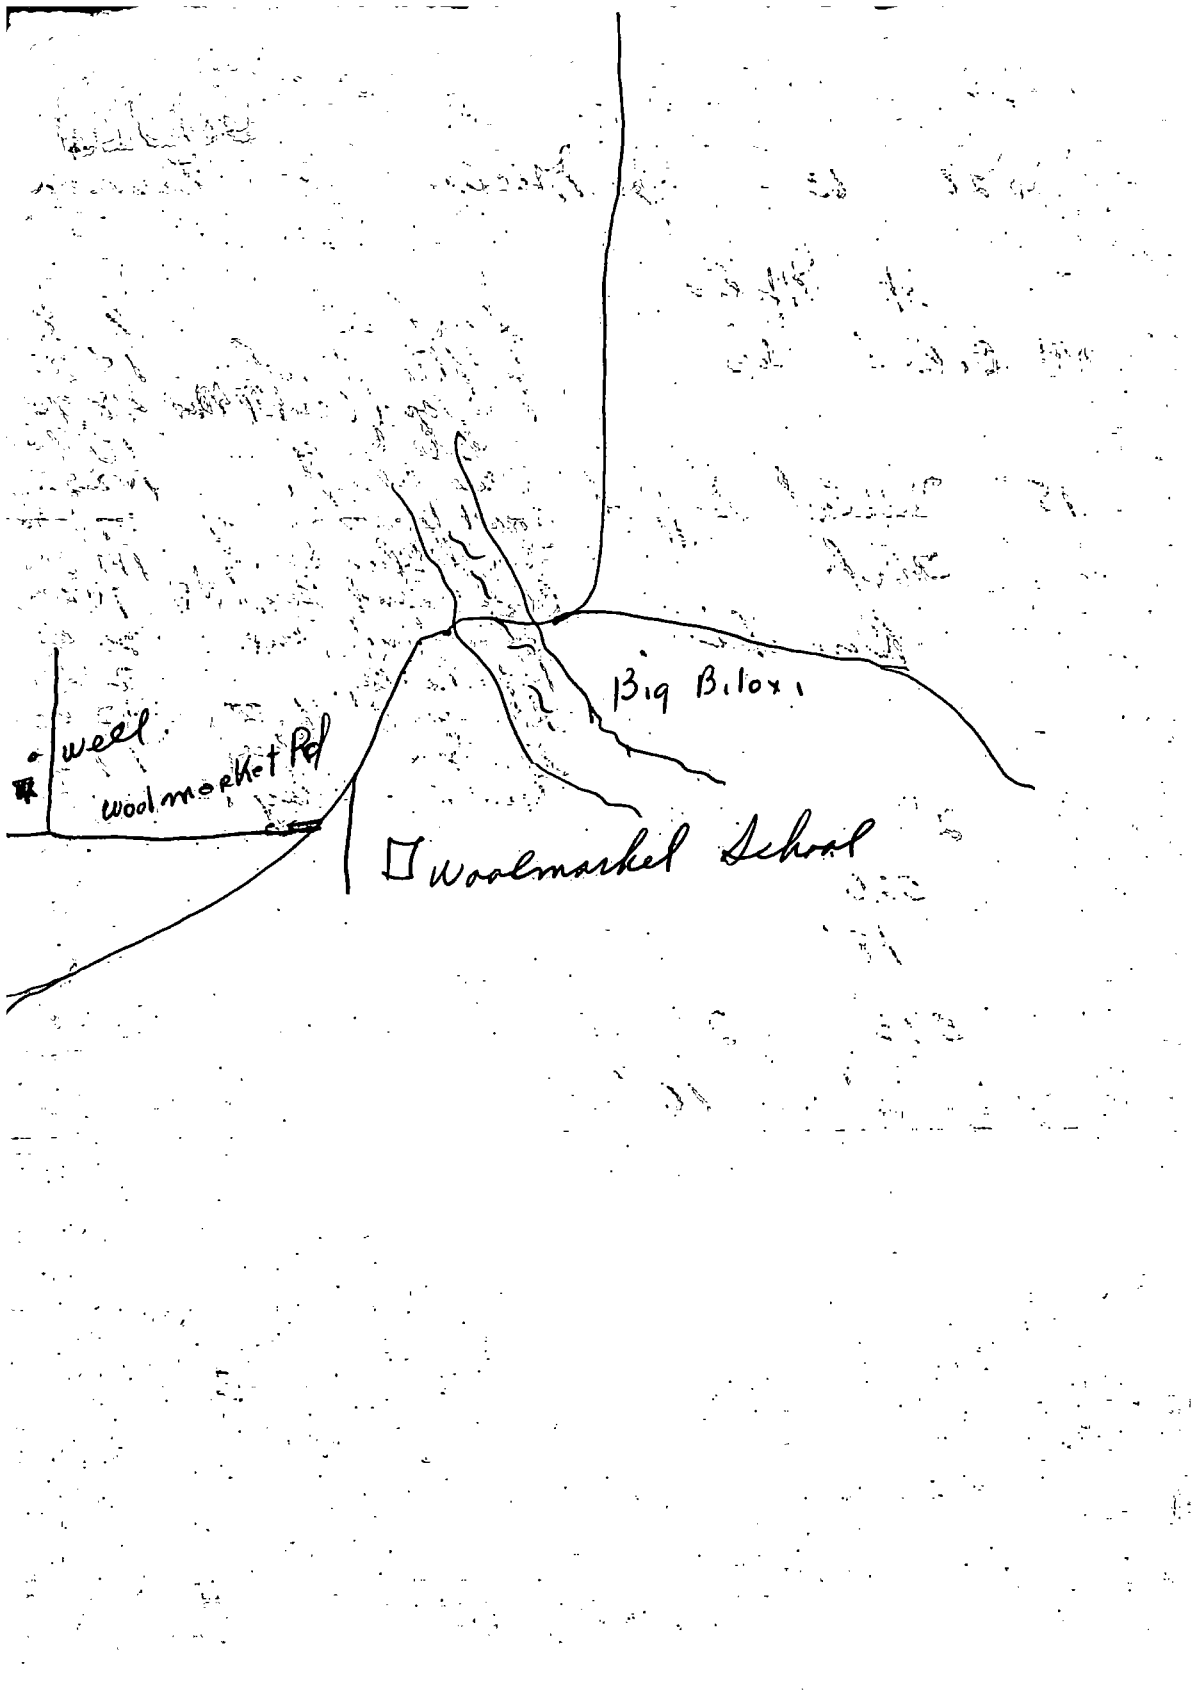

weel woolmarket Rd

Big Biloxi

Woolmarket School