

HAR.

MISSISSIPPI BOARD OF WATER COMMISSIONERS

CODED

H 17

8-30-62

WATER WELL DRILLERS LOG

Harrison
~~Jackson~~

Date: Aug 30, 1962, Driller: L. L. Garland County: Harrison
(Name)

(1) Owner of Land	Description & Color of Material Sand, Clay, Red Clay, Shell, etc.	Thick- ness Feet	Depth Feet
<u>Mr. Scarborough</u> (Name) <u>Biloxi, Miss.</u> (Address)	1 15' Clay 6' Sand		
(2) Location: $\frac{1}{4}$, $\frac{1}{4}$, Sec. <u>19 T₆R₁₀</u> <u>20</u> miles <u>North</u> of <u>Biloxi</u> (distance) (direction) (Nearest Town)	2 Sand		
(3) Topography: <input checked="" type="radio"/> (Hilly) <input type="radio"/> (Flat) <input type="radio"/> (Level)	3 17' " 4' Mud		
(4) Purpose of Well: <u>Domestic</u> (Domestic Irrigation Municipal, Industrial, Other)	4 Mixed		
	5-6 Mud		
	7 " 2 Sand Str.		
	8 6' Mud 15' Sand		
	9 Mud		
	10-11 Mud & Shale		
	12 18' " 3' Sand		
	13 Mixed		
	14 Mud		
	15 8' " 13' Mx		
	16 13' " 8' Sand		
	17 Fine Sand		
	18 14' Mix 7' Sand		
	19 Mud & Sand Str.		
	20 "		
	21 " " "		
	22 " Shale		
	23 Mixed		
	24 Sand		
	25 18' Sand (Good)		

Information upon completion of well:

(1) Diameter 2 inches.

(2) Total Depth 522 feet.

(3) Water Level 64 feet below top of ground.

(4) Cased to _____, Size _____

(5) Screen: Size .08, Length 10


(6) Were any formations sealed against pollution?
_____ yes, _____ no.

If YES depth of formation _____

Why _____

Drillers Remarks: _____

CODED

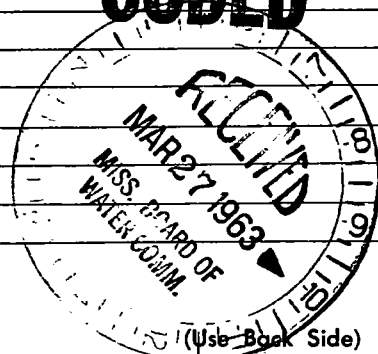

Well No. _____

