

HAR.

MISSISSIPPI BOARD OF WATER COMMISSIONERS

H 18

0536011

9-3-62

WATER WELL DRILLERS LOG

CODED

Date: Sept. 3, 1962, Driller: L. L. Harland County: Harrison

(Name)

(1) Owner of Land: L. C. Parker
(Name)
Biloxi, Miss.
(Address)

(2) Location: 1/4, 1/4, Sec 24 T6 R10 W
22 miles North, of Biloxi
(distance) (direction) (Nearest Town)

(3) Topography: (Hilly) (Flat) (Level)

(4) Purpose of Well: Dom.
(Domestic Irrigation
Municipal, Industrial, Other)

Description & Color of Materials Sand, Clay, Red Clay, Shell, etc.	Thick- ness Feet	Depth Feet
1-14' Clay 7' Sand		
2-16' Sand 5' Mud		
3- Mixed		
4- Mud		
5- "		
6- "		
7- Mixed		
8- 11' Mud 10' Sand		
9- Good		

Information upon completion of well:

(1) Diameter 2 inches.

(2) Total Depth 168 feet.

(3) Water Level 70 feet below top of ground.

(4) Cased to _____, Size _____

(5) Screen: Size .08, Length 10


(6) Were any formations sealed against pollution?
_____ yes, _____ no.

If YES depth of formation _____

Why _____

Drillers Remarks: _____

CODED

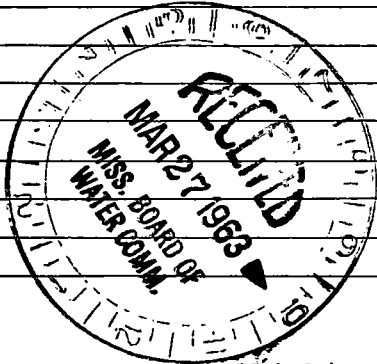

(Use Back Side)

Well No.

