

HAR.

MISSISSIPPI BOARD OF WATER COMMISSIONERS

H 21

K397603

2-6-63

WATER WELL DRILLERS LOG

CODED

Date: Feb. 6, 1963, Driller: Mac B Drilling Co. County Harrison
(Name)


Thomas H. Smith Water Company
 (1) Owner of Land: _____ (Name)
Woolmarket, Miss.
 (Address)
 (2) Location: _____ 1/4, _____ 1/4, Sec. 15 T. R. _____
 _____ miles _____ of _____
 (distance) (direction) (Nearest Town)
 (3) Topography: Flat
 (Hilly) (Flat) (Level)
 (4) Purpose of Well: Water System
 (Domestic Irrigation
 Municipal, Industrial, Other)

Description & Color of Materials Sand, Clay, Red Clay, Shell, etc.	Thick- ness Feet.	Depth Feet
<u>Top Clay</u>	<u>15</u>	<u>15</u>
Top Clay		
<u>Blue Clay</u>	<u>31</u>	<u>46</u>
<u>Fine Sand</u>	<u>4</u>	<u>50</u>
<u>Blue Clay</u>	<u>11</u>	<u>61</u>
<u>Sand Shell</u>	<u>2</u>	<u>63</u>
<u>Blue Clay</u>	<u>183</u>	<u>246</u>
<u>Fine Sand</u>	<u>12</u>	<u>258</u>
<u>Blue Clay</u>	<u>12</u>	<u>270</u>
<u>Medium Gravel</u>	<u>10</u>	<u>280</u>
<u>Coarse Sand & fine</u>		
<u>Crawl 25325m</u>	<u>45</u>	<u>325</u>

Information upon completion of well:
1 1/8" 4" Balance
 (1) Diameter 3 inches.
 (2) Total Depth 323 feet.
 (3) Water Level 1 feet below top of ground.
 (4) Cased to 303, Size 4" X 3"
 (5) Screen: Size 3" 105/16", Length 20 FT.
 (6) Were any formations sealed against pollution?
 _____ yes, _____ no.

Still getting fine
Crawl when stopped

CODED

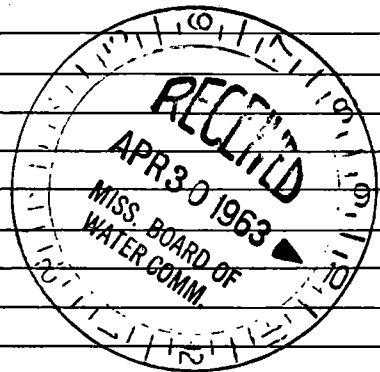

If YES depth of formation _____
 Why _____
 Drillers Remarks: _____

(Use Back Side)

Well No.

1903

[The remainder of the page contains extremely faint and illegible text, likely bleed-through from the reverse side of the document.]