

HAR.

MISSISSIPPI BOARD OF WATER COMMISSIONERS

23

A107411

6-28-63


WATER WELL DRILLERS LOG

CODED

Date: June 28, 1963, Driller: H. A. Ladnier County Harrison

(Name)

(1) Owner of Land:	Description & Color of Materials Sand, Clay, Red Clay, Shell, etc.	Thick- ness Feet	Depth Feet
Bobby W. W. Ladnier (Name) <u>Biloxi, Miss.</u> (Address) <u>26 6 10</u>	TOUCHSTONE <u>Red clay + sand</u> <u>Blue clay</u>	<u>60</u> <u>345</u>	
(2) Location: <u>1/4</u> , <u>1/4</u> , Sec <u>7 T25R9W</u> <u>1.2 miles</u> <u>North</u> of <u>Biloxi</u> (distance) (direction) (Nearest Town)			
(3) Topography: <u>Hilly</u> (Hilly) (Flat) (Level)			
(4) Purpose of Well: <u>Domestic</u> (Domestic Irrigation Municipal, Industrial, Other)			

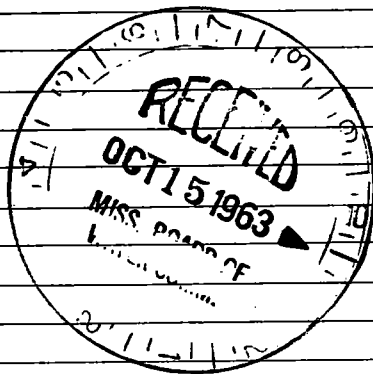

Information upon completion of well:

- (1) Diameter 2 inches.
- (2) Total Depth 445 feet.
- (3) Water Level 30 feet below top of ground.
- (4) Cased to 430, Size 2 inch.
- (5) Screen: Size 2 inch length 10.
- (6) Were any formations sealed against pollution?
 yes, no.

If YES depth of formation 30
 Why sand
 Drillers Remarks:

CODED

(Use Back Side)

Well No.

