

HAR.
H 28
7-63

MISSISSIPPI BOARD OF WATER COMMISSIONERS

WATER WELL DRILLERS LOG

Date: July 13, 1963, Driller: L. L. Garland County: Jackson
(Name)

(1) Owner of Land:	Description & Color of Materials Sand, Clay, Red Clay, Shell, etc.	Thick- ness Feet	Depth Feet
<u>Mr. Pug</u> (Name) <u>Hwy. #67</u> (Address)	1 12' Clay 6' s.s. 3' gravel		
(2) Location: <u>1/4</u> , <u>1/4</u> , Sec. <u>T</u> <u>R</u> , <u>6</u> miles <u>NW</u> <u>D. Abernethy</u> of (distance) (direction) (Nearest Town)	2 5' " 16' sand		
(3) Topography: <u>(Hilly)</u> (Flat) (Level)	3 s.s. & M.S.		
(4) Purpose of Well: <u>Dom.</u> (Domestic Irrigation Municipal, Industrial, Other)	4 18' m. 3' s.		
	5-6 mud		
	7 " s.s.		
	8-9-10-11 mud		
	12-13 mud & s.s.		
	14 "		
	15 18' m. 3' s.		
	16 mix		
	17 3' " 12' s. 6' m.		
	18- mud		
	19 shale		
	20 " s.s.		
	21' mix		
	22 sand coarse		
	24 " fine		
	25 mix		
	26-27- shale		
	28 " & mud		
	29 11' mix 10' shale		
	30 18' " 3 "		
	31 sand		
	32 mix		
	33 14' m. 17' sand		
	34 35' m. sand		

Information upon completion of well:

(1) Diameter 2 inches.

(2) Total Depth 735 feet.

(3) Water level 16 feet below top of ground.

(4) Cased to _____, Size _____


(5) Screen: Size .08, Length 10

(6) Were any formations sealed against pollution?
_____ yes, _____ no.

If YES depth of formation _____

Why _____

Drillers Remarks: _____

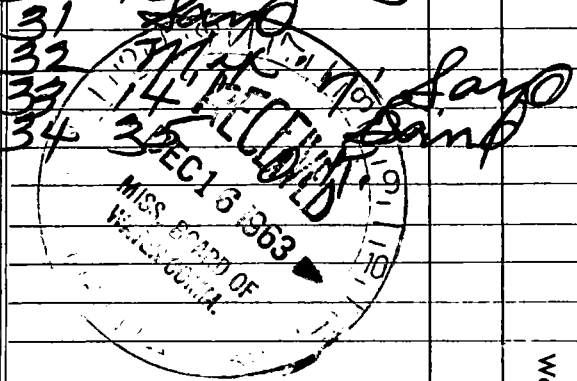

(Use Back Side)

Well No.

