

HAR.

MISSISSIPPI BOARD OF WATER COMMISSIONERS

H 29 W107809

7-3-63

WATER WELL DRILLERS LOG

CODED

Date: July 3, 1963, Driller: Hettingburg Butane County Harrison
(Name)

(1) Owner of Land:	Description & Color of Materials Sand, Clay, Red Clay, Shell, etc.	Thick- ness Feet	Depth Feet
<u>Lee Fayard</u> (Name)	<u>Red Clay</u>	0-20	
<u>Bitoni</u> (Address)	<u>White sand</u>	20-40	
(2) Location: <u>1/4</u> , <u>1/4</u> , Sec. <u>33 T6 R10</u>	<u>Yellow clay</u>	40-50	
<u>1</u> miles <u>N</u> of <u>Sakul</u> (distance) (direction) (Nearest Town)	<u>White sand</u>	50-100	
(3) Topography: <input checked="" type="checkbox"/> (Hilly) <input checked="" type="checkbox"/> (Flat) <input type="checkbox"/> (Level)	<u>Blue Clay</u>	100-200	
(4) Purpose of Well: <u>Domestic</u> (Domestic Irrigation Municipal, Industrial, Other)	<u>Blue sand</u>	200-220	

Information upon completion of well:


- (1) Diameter 2" inches.
- (2) Total Depth 220 feet.
- (3) Water Level 8 feet below top of ground.
- (4) Cased to _____, Size _____
- (5) Screen: Size 2", Length 10'
- (6) Were any formations sealed against pollution?
_____ yes, no.

If YES depth of formation _____

Why _____

Drillers Remarks: _____

CODED

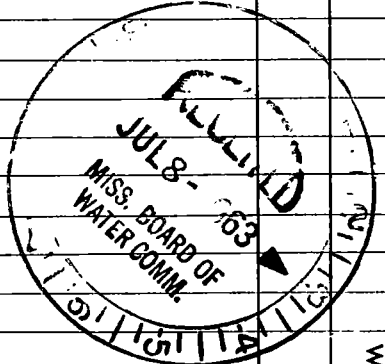

(Use Back Side)

Well No.

