

HAR.

MISSISSIPPI BOARD OF WATER COMMISSIONERS

H 30

7-3-63

WATER WELL DRILLERS LOG

Date: July 3, 1963, Driller: H. H. H. Butane County Harrison

(Name)

(1) Owner of Land L. H. Evans (Name)

Baloxi (Address)

(2) Location: 1/4, 1/4, Sec. T R

1 1/2 miles E of Walnut (distance) (direction) (Nearest Town)

(3) Topography: (Hilly) (Flat) (Level)

(4) Purpose of Well: Domestic (Domestic Irrigation Municipal, Industrial, Other)

Description & Color of Materials Sand, Clay, Red Clay, Shell, etc.	Thick- ness Feet	Depth Feet
White Clay	0-10	
White sand	10-25	
Gravel	25-30	
Yellow Clay	30-50	
Yellow Sand	50-80	
Blue Clay	80-100	
Blue Sand	100-115	
Blue Clay	115-160	
Blue Sand	160-170	
Blue Clay	170-235	
Blue Sand	235-245	
Blue Clay	245-380	
Blue Sand	380-400	

Information upon completion of well:

(1) Diameter 2" inches.

(2) Total Depth 400 feet.

(3) Water Level 28 feet below top of ground.

(4) Cased to, Size

(5) Screen: Size 2", Length 8'


(6) Were any formations sealed against pollution?

yes, X no.

If YES depth of formation

Why

Drillers Remarks:

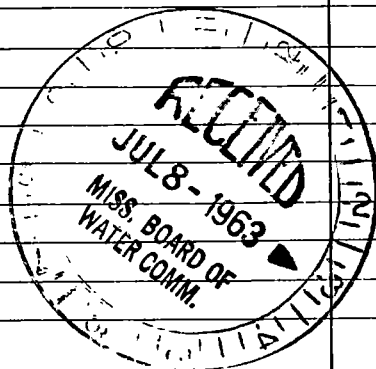

(Use Back Side)

Well No.

