

HAR.  
H 31  
7-10-63

WATER WELL DRILLERS LOG

Date: July 10, 1963, Driller: Joe Miller County Harrison  
(Name)

(1) Owner of Land: Sgt. Smith  
(Name)  
RR# Biloxi Miss  
(Address)

(2) Location: 1/4, 1/4, Sec. T R. R  
8 miles N.W. of Biloxi  
(distance) (direction) (Nearest Town)

(3) Topography: Flat  
(Hilly) (Flat) (Level)

(4) Purpose of Well: Domestic  
(Domestic Irrigation  
Municipal, Industrial, Other)

Description & Color of Materials Sand, Clay, Red Clay, Shell, etc.	Thick- ness Feet	Depth Feet
Surface		8
Blue clay	262	270
Sand, Fine	9	279
Blue clay	31	310
Sand, Fine	16	326
Sand, Fair	10	336
Sand, Good	15	351
Hard clay	1	352


Information upon completion of well:

- (1) Diameter 2 inches.
- (2) Total Depth 352 feet.
- (3) Water Level 4' feet below top of ground.
- (4) Cased to 340, Size 2"
- (5) Screen: Size 2', Length 10'
- (6) Were any formations sealed against pollution?  
\_\_\_\_\_ yes, \_\_\_\_\_ no.

If YES depth of formation \_\_\_\_\_

Why \_\_\_\_\_

Drillers Remarks: \_\_\_\_\_

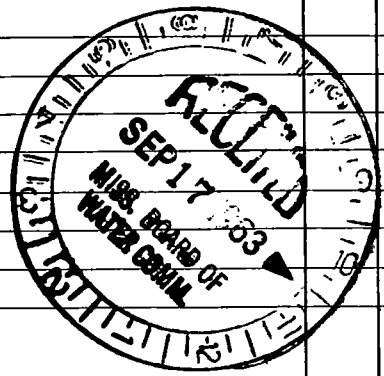

(Use Back Side)

Well No.

Back Bay

Sgt. Smith

Willie's Pa

Old Cedar  
Lake Rd

Pope Ferry

67-

N.