

H 34
8-10-61

WATER WELL DRILLERS LOG

H 300
Harrison
Jackson

Date: Aug. 10, 1961, Driller: L. L. Garland County Jackson
(Name)

(1) Owner of Land Mr. Robinson
(Name)
Rifle Range
(Address)

(2) Location: 1/4, 1/4, Sec. T. R.
12 miles NW., of Oberville
(distance) (direction) (Nearest Town)

(3) Topography: (Hilly) (Flat) (Level)

(4) Purpose of Well: (Domestic) Irrigation
Municipal, Industrial, Other

Description & Color of Materials Sand, Clay, Red Clay, Shell, etc.	Thick- ness Feet	Depth Feet
Clay		21
"		42
"		63
"		84
8" Mud		105
"		126
18" Mud 3' Sand		157
8" Mud		178
"		189
"		210
"		231
"		252
8" Mud & Sand Str.		273
" " "		294
" " "		315
8" Mud		336
"		357
"		378
"		399
"		420
Sand		441
10' Sand		451

Information upon completion of well:

(1) Diameter 2" inches.

(2) Total Depth 451 feet.

(3) Water Level 76 feet below top of ground.

(4) Cased to _____, Size _____


(5) Screen: Size .08, Length 10'

(6) Were any formations sealed against pollution?
_____ yes, _____ no.

If YES depth of formation _____

Why _____

Drillers Remarks: _____

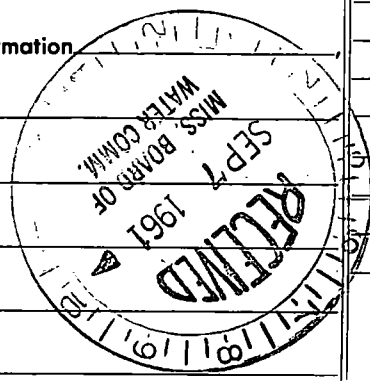

(Use Back Side)

Well No.

