

H 301

H 35
8-11-61

WATER WELL DRILLERS LOG

Harrison

Date: Aug 11, 1961, Driller: L. L. Garland County Jackson
(Name)

(1) Owner of Land: Marcus Martin
(Name)
Hwy. 15
(Address)

(2) Location: 1/4, 1/4, Sec. T. R.
8 miles NW of Oberville
(distance) (direction) (Nearest Town)

(3) Topography: (Hilly) (Flat) (Level)

(4) Purpose of Well:
(Domestic, Irrigation, Municipal, Industrial, Other)

Description & Color of Materials Sand, Clay, Red Clay, Shell, etc.	Thick- ness Feet	Depth Feet
<u>18 1/2 Clay 3' Sand</u>		<u>21</u>
<u>Sandy</u>		<u>42</u>
<u>8' Sand 13' Mud</u>		<u>63</u>
<u>14' Sand 7' Mud</u>		<u>84</u>
<u>Mixed</u>		<u>105</u>
<u>Mud</u>		<u>126</u>
<u>11' Sand</u>		<u>147</u>
		<u>168</u>

Information upon completion of well:

(1) Diameter 3 inches.

(2) Total Depth 168 feet.

(3) Water Level 6' feet below top of ground.

(4) Cased to , Size .


(5) Screen: Size .08, Length 6'.

(6) Were any formations sealed against pollution?
 yes, no.

If YES depth of formation

Why

Drillers Remarks:

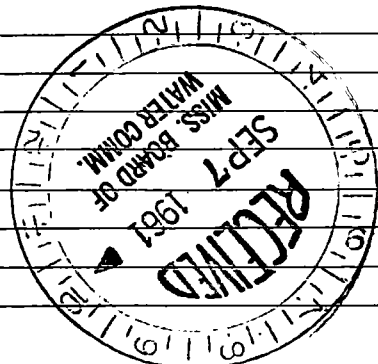

(Use Back Side)

Well No.

