

HAR.  
H39


MISSISSIPPI BOARD OF WATER COMMISSIONERS

9-29-63

WATER WELL DRILLERS LOG

Date: 9-29, 1963, Driller: Joe Miller County Jackson  
(Name)

(1) Owner of Land:	Description & Color of Materials Sand, Clay, Red Clay, Shell, etc.	Thick- ness Feet	Depth Feet
George Godwin (Name) RR# Belair Miss (Address)	Whit-red Cl.	25	25
	Blue Clay	80	105
(2) Location: 1/4, 1/4, Sec. T R	Small Sand, streak Clay	46	151
7 miles North of Belair (distance) (direction) (Nearest Town)	Hard Blue Clay	84	235
(3) Topography: Hilly (Hilly) (Flat) (Level)	Fne Blue Sand (Fine)	7	242
(4) Purpose of Well: Domestic (Domestic Irrigation Municipal, Industrial, Other)	Fne Blue Sand - (Fair)	11	253
Information upon completion of well:	" " "	10	263
(1) Diameter 2" inches.	Hd Blue Clay	2	265
(2) Total Depth 265' feet.			
(3) Water Level 8' feet below top of ground.			
(4) Cased to 253', Size 2"			
(5) Screen: Size 2", Length 10'			
(6) Were any formations sealed against pollution? yes, no.			
If YES depth of formation			
Why			
Drillers Remarks:			

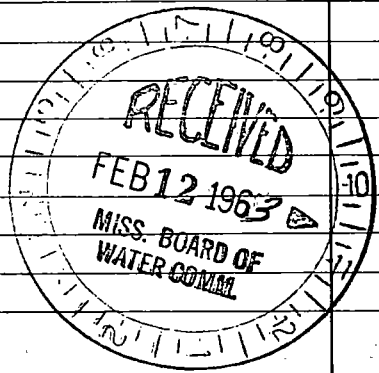

(Use Back Side)

Well No.

Boch Bay

67

Red Sku 20

Starfall Rd

well

Salmon Gill Tows

