

H 44
10-25-63

WATER WELL DRILLERS LOG

Date: 10-25, 1963, Driller: Wadsworth Butane County, Jackson
(Name)

(1) Owner of Land: W. B. McLeod
(Name)
Rt 1 Biloxi, Miss
(Address)
Woolmarket

(2) Location: 1/4, 1/4, Sec. T R
_____ miles _____ of _____
(distance) (direction) (Nearest Town)

(3) Topography: _____
(Hilly) (Flat) (Level) X

(4) Purpose of Well: domestic
(Domestic Irrigation
Municipal, Industrial, Other)

Description & Color of Materials Sand, Clay, Red Clay, Shell, etc.	Thick- ness Feet	Depth Feet
<u>yellow clay</u>	<u>0-8</u>	
<u>white clay</u>	<u>8-18</u>	
<u>red clay</u>	<u>18-28</u>	
<u>white clay</u>	<u>28-36</u>	
<u>blue clay</u>	<u>36-50</u>	
<u>blue sand</u>	<u>50-60</u>	
<u>blue clay</u>	<u>60-200</u>	
<u>blue sand</u>	<u>200-220</u>	

Information upon completion of well:

(1) Diameter 2" inches.

(2) Total Depth 220 feet.

(3) Water Level 19 feet below top of ground.

(4) Cased to _____, Size _____


(5) Screen: Size 2", Length 10'

(6) Were any formations sealed against pollution?
_____ yes, _____ no.

If YES depth of formation _____

Why _____

Drillers Remarks: _____

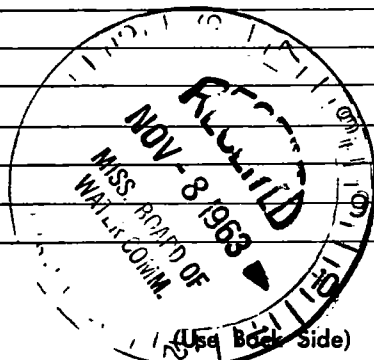

Well No.

