

HARRISON
H 45
10-9-70

MISSISSIPPI
 BOARD OF WATER COMMISSIONERS
 416 North State Street
 Jackson, Mississippi 39201

CODED

WATER WELL DRILLERS LOG

Oct. 9 1970 McBill Well Works HARRISON
 date well completed firm name county well located

LANDOWNER: HUR SNOWDEN
1956 Pass Road
Gulfport, Miss.
 (mailing address)

description of formations encountered	from	to
<u>mud</u>	<u>0</u>	<u>442</u>
<u>sand</u>	<u>442</u>	<u>480</u>

WELL LOCATION:
 sec. 30 T. 6 N. R. 10 E
6 miles East of Lynon
 (distance) (direction) (nearest town)

WELL PURPOSE: Home
 (home, irrigation, municipal, industrial)

- WELL COMPLETION DATA:
- (1) diameter (inches) 2"
 - (2) total depth (feet) 480'
 - (3) static water level (feet) 50' below above top of ground.
 - (4) casing galvanized 460'
 (material) (depth)
NO if telescope see back.
 (size)
 - (5) screen 10' (length) (depth to top)
2" (size) 3.5 (material)
 - (6) pump 1 (HP) 15 (yield gpm)
Electric (type power)
 - (7) electric log NO (yes or no)
NO (organization running log)
 - (8) how well bottom plugged Sand
Struck

CODED


APR - 1 1971

DRILLERS REMARKS:

MISS. Bd. OF
 WATER COM.:

If well telescopes please sketch and show depths.

GROUND LEVEL

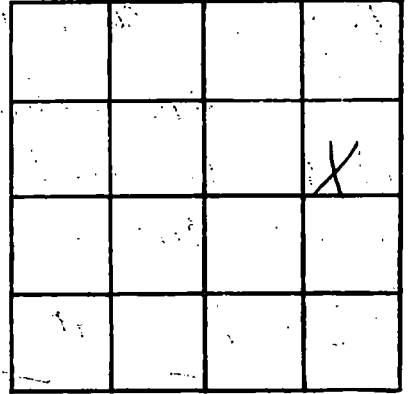

SECTION 30

Please indicate well location X.

ADDITIONAL INFORMATION

If more than one screen, show locations of each on sketch.