

HAR,

MISSISSIPPI BOARD OF WATER COMMISSIONERS

H 46

W 108111

5-18-64

WATER WELL DRILLERS LOG

CODED

Date: 5-18, 1964, Driller: Hattiesburg Butte County Harrison
(Name)

(1) Owner of Land: Wydele Raley
(Name)
Biloxi, Miss
(Address)
Woolmarket
(2) Location: 1/4, 1/4, Sec. 34 T 6 R 10,
_____ miles _____ of _____
(distance) (direction) (Nearest Town)
(3) Topography: _____ _____
(Hilly) (Flat) (Level)
(4) Purpose of Well: domestic
(Domestic Irrigation
Municipal, Industrial, Other)


Description & Color of Materials Sand, Clay, Red Clay, Shell, etc.	Thick- ness Feet	Depth Feet
<u>white sand</u>	<u>0-8</u>	<u>8</u>
<u>Red clay</u>	<u>8-25</u>	<u>25</u>
<u>Red sand</u>	<u>25-30</u>	<u>30</u>
<u>Red clay</u>	<u>30-65</u>	<u>65</u>
<u>white clay</u>	<u>65-100</u>	<u>100</u>
<u>yellow clay</u>	<u>100-150</u>	<u>150</u>
<u>Blue clay</u>	<u>150-400</u>	<u>400</u>
<u>Blue sand</u>	<u>400-440</u>	<u>440</u>

Information upon completion of well:

(1) Diameter 2 inches.
(2) Total Depth 440 feet.
(3) Water Level 30 feet below top of ground.
(4) Cased to _____, Size _____
(5) Screen: Size 2", Length 10'
(6) Were any formations sealed against pollution?
_____ yes, no.

CODED

If YES depth of formation _____
Why _____
Drillers Remarks: _____

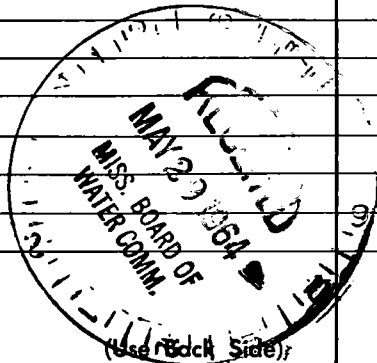

Well No.

11111

11111

