

HAR.

MISSISSIPPI BOARD OF WATER COMMISSIONERS

H47

5-26-64

WATER WELL DRILLERS LOG

Date: 5-26, 1964, Driller: Hattusburg Butner County Harrison (Name)

(1) Owner of Land: G. B. Williams
 (Name)
Biloxi, Miss.
 (Address)

(2) Location: 1/4, 1/4, Sec T R
Woolmarket
 miles of
 (distance) (direction) (Nearest Town)

(3) Topography: X
 (Hilly) (Flat) (Level)

(4) Purpose of Well: Domestic
 (Domestic Irrigation
 Municipal, Industrial, Other)

| Description & Color of Materials Sand, Clay, Red Clay, Shell, etc. | Thick- ness Feet | Depth Feet |
|-----------------------------------------------------------------------|------------------------|---------------|
| yellow clay | 0-12 | |
| Red clay | 12-28 | |
| white sand | 28-36 | |
| white clay | 36-75 | |
| Blue clay | 75-86 | |
| Blue sand | 86-90 | |
| Blue clay | 90-274 | |
| Blue sand | 274-280 | |
| Blue clay | 280-290 | |

Information upon completion of well:

(1) Diameter 2 inches.

(2) Total Depth 290 feet.

(3) Water Level 30 feet below top of ground.

(4) Cased to _____, Size _____


(5) Screen: Size 2", Length 10'

(6) Were any formations sealed against pollution?
 _____ yes, _____ no.

If YES depth of formation _____

Why _____

Drillers Remarks: _____

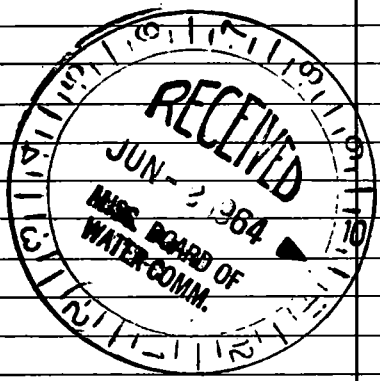

(Use Back Side)

Well No.

