

OH 48

8-24-64

WATER WELL DRILLERS LOG

W108308

CODED

Date: 8-24, 1964, Driller: C. I. SWITZER WELL CO County Harrison

(Name)

(1) Owner of Land: Wick Dana
(Name)

127 A Pass Rd. Belzoni
(Address) Miss

(2) Location: 1/4, 1/4, Sec. T R
35 610
miles of (distance) (direction) (Nearest Town)

(3) Topography: (Hilly) (Flat) (Level)

(4) Purpose of Well: Domestic
(Domestic Irrigation, Municipal, Industrial, Other)

Description & Color of Materials Sand, Clay, Red Clay, Shell, etc.	Thick- ness Feet	Depth Feet
<u>Sand</u>	<u>00</u>	<u>36</u>
<u>Clay</u>	<u>36</u>	<u>57</u>
<u>Sand</u>	<u>57</u>	<u>63</u>
<u>Clay</u>	<u>63</u>	<u>137</u>
<u>Sand</u>	<u>137</u>	<u>147</u>
<u>Clay</u>	<u>147</u>	<u>205</u>
<u>Sand</u>	<u>205</u>	<u>210</u>
<u>Sand, fair</u>	<u>210</u>	<u>231</u>
<u>Sand, good</u>	<u>231</u>	<u>256</u>

Information upon completion of well:

(1) Diameter 2 inches.

(2) Total Depth 256 feet.

(3) Water Level 25 - feet below top of ground.

(4) Cased to 256', Size 2"

(5) Screen: Size 2" Length 10'

(6) Were any formations sealed against pollution?


X yes, no.

If YES depth of formation

Why Health Dept. Reports

Drillers Remarks:

CODED

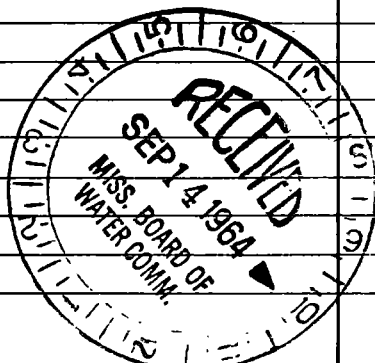

(Use Back Side)

Well No.

