

HAR.

MISSISSIPPI BOARD OF WATER COMMISSIONERS

H 49

W 106703

WATER WELL DRILLERS LOG

CODED

7-20-64

Date: July 20, 1964, Driller: Joe Miller County: Harrison
(Name)

(1) Owner of Land: C. H. Ludlow
(Name)

RR # 1 Box 99 Sulphur
(Address)

(2) Location: Curry Road, 22 1/4, 1/4, Sec. 22 T6R10

4 miles NE, of Woodmarket
(distance) (direction) (Nearest Town)

(3) Topography: Hilly
(Hilly) (Flat) (Level)

(4) Purpose of Well: Domestic
(Domestic Irrigation, Municipal, Industrial, Other)

Description & Color of Materials Sand, Clay, Red Clay, Shell, etc.	Thick- ness Feet	Depth Feet
<u>Surface</u>	<u>10</u>	<u>10</u>
<u>Wh. Sand Gravel</u>	<u>38</u>	<u>48</u>
<u>Reddish Clay</u>	<u>58</u>	<u>106</u>
<u>White Clay</u>	<u>28</u>	<u>134</u>
<u>Hard Blue Clay</u>	<u>261</u>	<u>395</u>
<u>Gray Sand Fine</u>	<u>26</u>	<u>421</u>
<u>" " Fair</u>	<u>52</u>	<u>453</u>
<u>" " Sand</u>	<u>11</u>	<u>464</u>
<u>" " Red Gravel</u>	<u>18</u>	<u>482</u>
<u>Blue Clay</u>		<u>485</u>

Information upon completion of well:

(1) Diameter 2 inches.

(2) Total Depth 485 feet.

(3) Water Level 64' feet below top of ground.

(4) Cased to 412, Size 2'

(5) Screen: Size 2", Length 10'


(6) Were any formations sealed against pollution?
_____ yes, _____ no.

If YES depth of formation 10' down.

Why _____

Drillers Remarks: _____

CODED

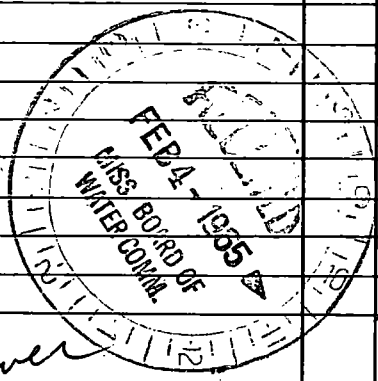

(Use Back Side)

Well No.

000000

Point
River

Wind
Sands



Shallow



Camp

Route
67

