

HAR.
H 51 #

MISSISSIPPI BOARD OF WATER COMMISSIONERS

WATER WELL DRILLERS LOG

11-3-64

Date: 11-3-64, 19___, Driller: C.T. Surtow Well Co County Harrison
(Name)

(1) Owner of Land: Stanley Besarge
(Name)

Hudson Rd Rt 1 Belpre
(Address)

(2) Location: ___ 1/4, ___ 1/4, Sec. ___ T ___ R ___
___ miles of ___
(distance) (direction) (Nearest Town)

(3) Topography: (Hilly) (Flat) (Level)

(4) Purpose of Well: Domestic
(Domestic Irrigation, Municipal, Industrial, Other)

Description & Color of Materials Sand, Clay, Red Clay, Shell, etc.	Thick- ness Feet	Depth Feet
Clay	0	18
Sand	18	31
Clay	31	63
Sand, fair	63	84
Sand	84	94
Clay	94	210
Sand	210	225
Fuller's soil	225	231
Clay + sand streaks	231	251
Clay	251	281
Sand	281	291
Sand, good	291	337

Information upon completion of well:

(1) Diameter 2 inches.

(2) Total Depth 337 feet.

(3) Water Level 50' feet below top of ground.

(4) Cased to 337', Size 2"


(5) Screen: Size 2", Length 10'

(6) Were any formations sealed against pollution?
 yes, ___ no.

If YES depth of formation: ___

Why Health Dept Permits

Drillers Remarks:

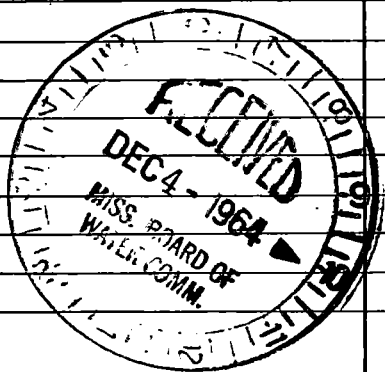

(Use Back Side)

Well No.

