

HAR.

MISSISSIPPI BOARD OF WATER COMMISSIONERS

Q H52 A107209

CODED

10-1-64

WATER WELL DRILLERS LOG

C. T. SWITZER WELL CO.

Date: Oct 1, 1964, Driller: \_\_\_\_\_ County: Harrison

(Name)

(1) Owner of Land: Harold B. Rushing

(Name)

Highway 64, Sallisie

(Address)

(2) Location: 1/4, 1/4, Sec. 26 T. 6 R. 10

         miles          of           
(distance) (direction) (Nearest Town)

(3) Topography:  (Hilly)  (Flat)  (Level)

(4) Purpose of Well: Domestic  
(Domestic Irrigation, Municipal, Industrial, Other)

Information upon completion of well:

(1) Diameter 2 inches.

(2) Total Depth 519 feet.

(3) Water Level 46 1/2 feet below top of ground.

(4) Cased to 519, Size 2"

(5) Screen: Size 2", Length 10'

(6) Were any formations sealed against pollution?  
 yes,  no.


If YES depth of formation \_\_\_\_\_

Why Health Dept. Requirement

Drillers Remarks: \_\_\_\_\_

Description & Color of Materials Sand, Clay, Red Clay, Shell, etc.	Thick- ness Feet	Depth Feet
clay	80	21
sand	21	42
clay	79	121
sand	189	210
clay, fine	204	230
clay	210	251
sand & clay str	294	315
sand	315	328
clay	328	399
sand, red	399	420
sand	420	428
clay, fine	425	441
sand & clay str	441	462
clay	462	473
sand, good	473	519

CODED

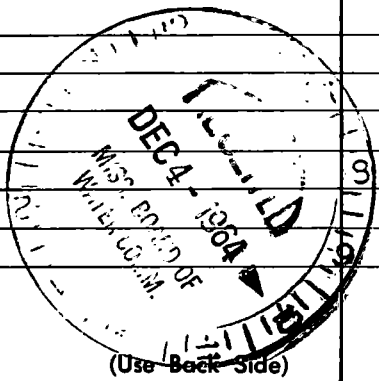

Well No.

0000