

Harrison
H 54
6-66

WATER WELL DRILLERS LOG

CODED

Date: June 17, 1966, Driller: Joe Miller County Harrison
(Name)

(1) Owner of Land: Edward Baker
(Name)
RR# Belair Miss.
(Address)

(2) Location: SW 1/4, NE 1/4, Sec. 23 T8S R10W
5 miles East of Abolmarch
(distance) (direction) (Nearest Town)

(3) Topography: Flat
(Hilly) (Flat) (Level)

(4) Purpose of Well: Domestic
(Domestic Irrigation
Municipal, Industrial, Other)

Description & Color of Materials Sand, Clay, Red Clay, Shell, etc.	Thick- ness Feet	Depth Feet
<u>Brown Clay Hard.</u>	<u>9</u>	<u>9</u>
<u>Sand & Pear Gravel.</u>	<u>11</u>	<u>20</u>
<u>White & Pink Clay.</u>	<u>42</u>	<u>62</u>
<u>Blue Clay.</u>	<u>34</u>	<u>96</u>
<u>Splinter & Wood.</u>	<u>19</u>	<u>115</u>
<u>Hard Blue Clay.</u>	<u>263</u>	<u>378</u>
<u>Soft Sand, Fair</u>	<u>11</u>	<u>389</u>
<u>Sand, (Gray) Fair</u>	<u>12</u>	<u>401</u>
<u>Sand, " Good</u>	<u>10</u>	<u>411</u>
<u>Sand, " Good</u>	<u>11</u>	<u>422</u>
<u>Sand, " Good</u>	<u>5</u>	<u>427</u>
<u>Clay</u>		<u>431</u>

Information upon completion of well:

(1) Diameter 2 1/2 inches.

(2) Total Depth 431 feet.

(3) Water Level 62 feet below top of ground.

(4) Cased to 417, Size 2"


(5) Screen: Size 2 1/2, Length 10'

(6) Were any formations sealed against pollution?
_____ yes, _____ no.

If YES depth of formation _____
Why _____
Drillers Remarks: _____

CODED

5' Tool Pipes

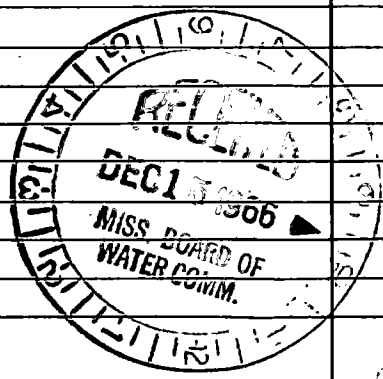

(Use Back Side)

Well No.

