

A106911

MISSISSIPPI  
BOARD OF WATER COMMISSIONERS  
416 North State Street  
Jackson, Mississippi 39201

**CODED**

WATER WELL DRILLERS LOG

Harrison  
H 58  
3-67

MARCH 13, 1967 HATTIESBURG Butave HARRISON  
date well completed firm name county well located

LANDOWNER: O. J. FORBURN  
Route 3 Box 14  
Beloxi, Miss.  
(mailing address)


WELL LOCATION:  
sec. 24 T. 6 S. R. 10 W.  
10 miles NORTH of Beloxi  
(distance) (direction) (nearest town)

WELL PURPOSE: Home  
(home, Irrigation, municipal, industrial)

- WELL COMPLETION DATA:
- (1) diameter (inches) 2"
  - (2) total depth (feet) 210'
  - (3) static water level (feet) 63' below above top of ground.
  - (4) casing Galv. pipe, 197'  
(material) (depth)  
2" if telescope see back.  
(size)
  - (5) screen 10', 200'  
(length) (depth to top)  
2" bronze  
(size) (material)
  - (6) pump 1 350  
(HP) (yield gpm)  
electric  
(type power)
  - (7) electric log no  
(yes or no)  
no  
(organization running log)
  - (8) how well bottom plugged Rock wash valve

description of formations encountered	from to	
yellow clay	0	15
Red sand	15	20
white sand	20	67
yellow sand	67	84
Red sand	84	112
white clay	112	132
blue clay	132	145
blue sand	145	148
blue clay	148	187
blue sand	187	210


**CODED**

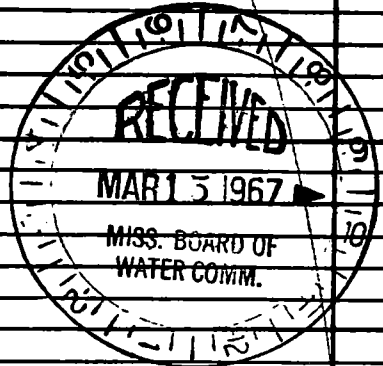

DRILLERS REMARKS:

If well telescopes please sketch and show depths.

GROUND LEVEL

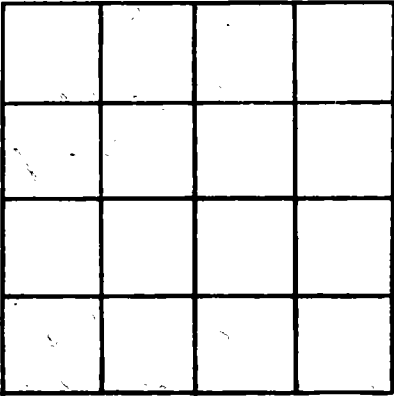

SECTION \_\_\_\_\_

Please indicate well location X.

ADDITIONAL INFORMATION

Lined area for additional information, consisting of 20 horizontal lines.

If more than one screen, show locations of each on sketch.