

Harrison
H 60
3-67

MISSISSIPPI
BOARD OF WATER COMMISSIONERS
416 North State Street
Jackson, Mississippi 39201

CODED

WATER WELL DRILLERS LOG

MARCH 18, 1967 Hattiesburg Butace HARRISON
date well completed firm name county well located

LANDOWNER: W. E. BROSETT
Route 2 Box 311
Biloxi, Miss.
(mailing address)

WELL LOCATION:
sec 32 T 6 S R 9 W
10 miles NW of Biloxi
(distance) (direction) (nearest town)
ON Highway 15


WELL PURPOSE: Home
(home, irrigation, municipal, industrial)

WELL COMPLETION DATA:

- (1) diameter (inches) 2"
- (2) total depth (feet) 287'
- (3) static water level (feet) 8' below top of ground.
- (4) casing GAL. pipe 274' (material) (depth)
2" (size) if telescope see back.
- (5) screen 10' (length) 277' (depth to top)
2" (size) bronze (material)
- (6) pump 1 (HP) 375 (yield gpm)
electric (type power)
- (7) electric log no (yes or no)
no (organization running log)
- (8) how well bottom plugged BACK WASH VALVE

description of formations encountered	from	to
Black Sand	0	5
Yellow Clay	5	10
White Clay	10	16
Blue Clay	16	25
White Clay	25	28
White Sand	28	51
Blue Clay	51	69
Blue Sand	69	84
Blue Clay	84	102
Blue Sand	102	114
Blue Clay	114	168
Blue Sand + blue clay	168	268
Blue Sand	268	287


CODED

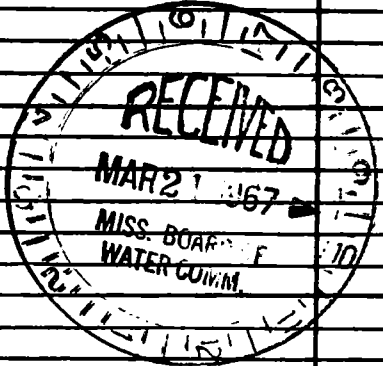

DRILLERS REMARKS:

If well telescopes please sketch and show depths.

GROUND LEVEL

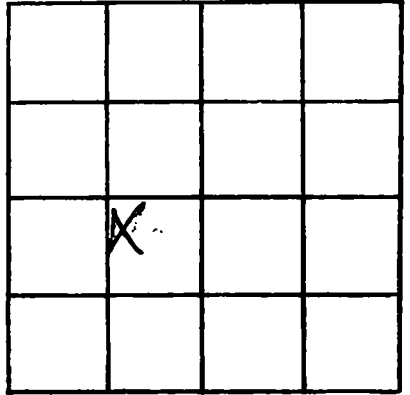

SECTION 32

Please indicate well location X.

ADDITIONAL INFORMATION

If more than one screen, show locations of each on sketch.