

Harrison  
 # 61  
 3-67

MISSISSIPPI  
 BOARD OF WATER COMMISSIONERS  
 416 North State Street  
 Jackson, Mississippi 39201

**CODED**

WATER WELL DRILLERS LOG

3-15 1967 date well completed  
 Switzer Well Co. firm name  
 Harrison county well located

LANDOWNER: Johnny Williams

description of formations encountered

from

to

Off Hwy. 15 East State Park on Gravel Road

deepened from 228'

Rt. 1 Box 264 Lumbia Miss  
 (mailing address)

clay 228 260

sand streaks 260 270

WELL LOCATION:

clay 270 275

sec. 33 T. 6 N R. 9 W  
5 1/2 miles N of BLOXIE  
 (distance) (direction) (nearest town)

sand 275 290

good sand 290 310

sand 310 315

WELL PURPOSE: home  
 (home, irrigation, municipal, industrial)

WELL COMPLETION DATA:

(1) diameter (inches) 2

(2) total depth (feet) 315

(3) static water level (feet) 30 below top of ground.

(4) casing gal. steel 305'  
 (material) (depth)

2" if telescope see back.  
 (size)

(5) screen gal. steel 305'  
 (length) (depth to top)

2" sga ss on pipe  
 (size) (material)

(6) pump 3/4 (HP) (yield gpm)

electric  
 (type power)


(7) electric log No  
 (yes or no)

(organization running log)

(8) how well bottom plugged back pressure valve


DRILLERS REMARKS:

**CODED**

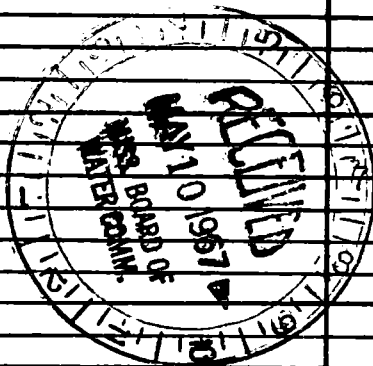

If well telescopes please sketch and show depths.

GROUND LEVEL

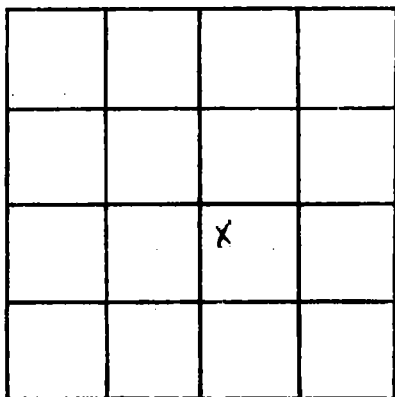

SECTION 37

Please indicate well location X.

ADDITIONAL INFORMATION

If more than one screen, show locations of each on sketch.