

Harrison
H 63
5-67

MISSISSIPPI
BOARD OF WATER COMMISSIONERS
416 North State Street
Jackson, Mississippi 39201

CODED

WATER WELL DRILLERS LOG

5-10 1967 date well completed
Switzer Shell Co. firm name
Harrison county well located

LANDOWNER: C.W. Roberts
3 mi. past Woodlark School
on John Lee Road.
Rt. 1 Box 750 Biloxi
(mailing address)

description of formations encountered	from	to
clay	0	83
clay + sand streaks	83	104
clay	104	223
sand	223	227
medium sand	227	248
good sand	248	270


WELL LOCATION:
sec. 29 T. 6 S. R. 10 E. W.
2 miles NE of WOODLARK
(distance) (direction) (nearest town)

WELL PURPOSE: Home
(home, irrigation, municipal, industrial)

WELL COMPLETION DATA:

- (1) diameter (inches) 2
- (2) total depth (feet) 270
- (3) static water level (feet) 37 below top of ground.
- (4) casing gal. steel 260' (material) (depth)
2" (size) if telescope see back.
- (5) screen 10' (length) 260' (depth to top)
8ga (size) ss on pipe (material)
- (6) pump 1/2 (HP) 8.5 (yield gpm)
electric (type power)
- (7) electric log No (yes or no)
(organization running log)
- (8) how well bottom plugged back pressure valve


CODED

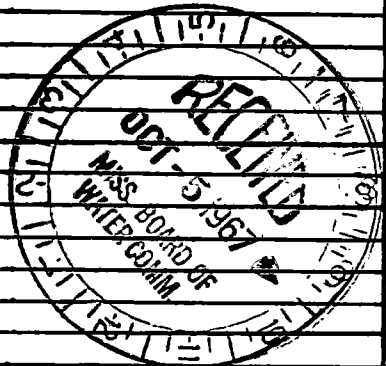

DRILLERS REMARKS:

If well telescopes please sketch and show depths.

GROUND LEVEL

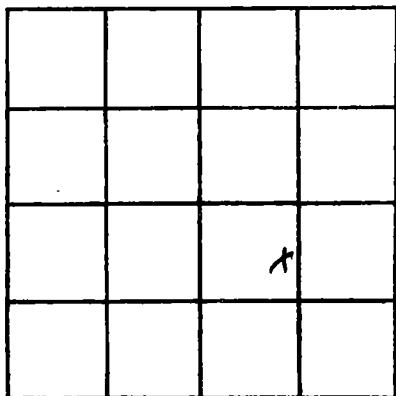

SECTION 29

Please indicate well location X.

ADDITIONAL INFORMATION

If more than one screen, show locations of each on sketch.