

Harrison
H 64
5-67

MISSISSIPPI
BOARD OF WATER COMMISSIONERS
416 North State Street
Jackson, Mississippi 39201
WATER WELL DRILLERS LOG

CODED

5-5 1967 Switzer Well Co. Harrison
date well completed firm name county well located

LANDOWNER Jerry Datum
Route 1 Box 794 Biloxi
(mailing address)


description of formations encountered	from	to
Clay	0	12
Sand	12	62
Clay	62	194
Clay + sand streaks	194	226
Fine sand	226	287
Good sand	287	316
Clay	316	363
Medium sand	363	427
Gravel sand	427	469

WELL LOCATION:
sec. 22 T. 6 S. R. 10 W.
15 miles N.W. of Biloxi
(distance) (direction) (nearest town)

WELL PURPOSE: Home
(home, irrigation, municipal, industrial)

- WELL COMPLETION DATA:
- (1) diameter (inches) 2
 - (2) total depth (feet) 469
 - (3) static water level (feet) 49 below top of ground.
 - (4) casing gal. steel, 459'
(material) (depth)
2" if telescope see back.
(size)
 - (5) screen 10', 459'
(length) (depth to top)
10 ga. stainless steel
(size) (material) on pipe
 - (6) pump not installed
(HP) (yield gpm)
 - (type power)
 - (7) electric log No
(yes or no)
(organization running log)
 - (8) how well bottom plugged back pressure valve

CODED

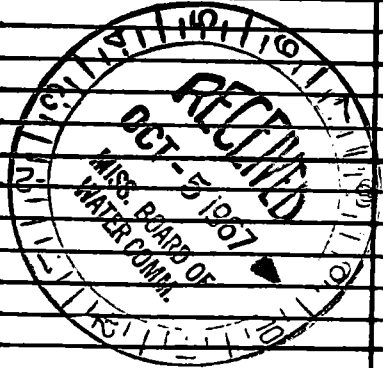

DRILLERS REMARKS:

If well telescopes please sketch and show depths.

GROUND LEVEL

			X

SECTION 22

Please indicate well location X.

ADDITIONAL INFORMATION

If more than one screen, show locations of each on sketch.