

HARRISON
H67
6-67

MISSISSIPPI
BOARD OF WATER COMMISSIONERS
416 North State Street
Jackson, Mississippi 39201

CODED

WATER WELL DRILLERS LOG

June 3 1967 Mt B Drilling Co Harrison
date well completed firm name county well located

LANDOWNER: Mary Armstrong
Tim Byrd Rd - Woolmarket
R. R. Biloxi, Miss.
(mailing address)

description of formations encountered	from	to
Surface	0	7
White + yellow clay	7	15
Red Clay	15	35
White Clay	35	40
Brown Sand & Clay	40	60
Brown Sand	60	105
Blue Clay	105	108
Grey Sand	108	116
Blue Clay	116	120
Grey Sand	120	143


WELL LOCATION:
sec. 34 T. 6 S. R. 10 E. W.
1/8 miles E of Woolmarket
(distance) (direction) (nearest town)

WELL PURPOSE: Home
(home, irrigation, municipal, industrial)

WELL COMPLETION DATA:

- (1) diameter (inches) 2"
- (2) total depth (feet) 143
- (3) static water level (feet) 18 below top of ground
- (4) casing PRC 134
(material) (depth)
- (size) if telescope see back.
- (5) screen 9 FT 134
(length) (depth to top)
- 2" Kitterpac PRC
(size) (material) sand
- (6) pump 1/2 12
(HP) (yield gpm)
- 110 Volt
(type power)
- (7) electric log No
(yes or no)
- (organization running log)
- (8) how well bottom plugged PRC Cap

CODED

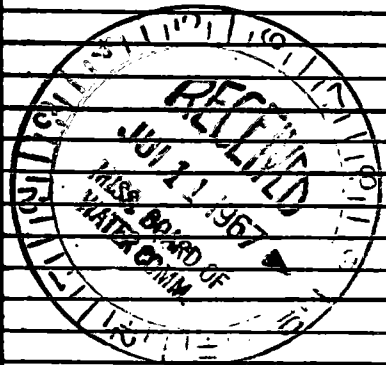

DRILLERS REMARKS:

If well telescopes please sketch and show depths.

GROUND LEVEL

			X

SECTION 34

Please indicate well location X.

ADDITIONAL INFORMATION

If more than one screen, show locations of each on sketch.