


# CODED

MISSISSIPPI  
 BOARD OF WATER COMMISSIONERS  
 416 North State Street  
 Jackson, Mississippi 39201

WATER WELL DRILLERS LOG

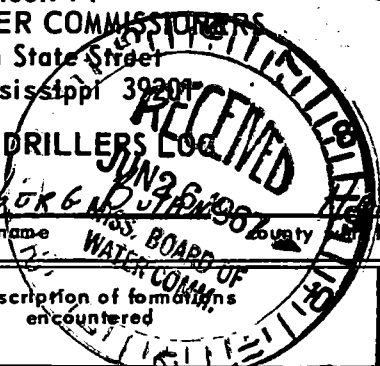

HARRISON  
 H68  
 6-67

date well completed 6-23 1967 HATTIESBORO MISS. COUNTY HARRISON

LANDOWNER: B. F. Douglas

description of formations encountered

from to

Route 1 box 635

Yellow clay	0	9
White clay	10	16
White sand	17	57
Blue clay	58	140
Blue sand	141	155
Blue sand	156	180
Blue clay	181	285
Blue sand	286	306

Biloxi, Miss.  
 (mailing address)

WELL LOCATION:


sec. 34 T. 6 S. R. 10 W.  
 1 miles EAST of Wood Market  
 (distance) (direction) (nearest town)

WELL PURPOSE: Home  
 (home, irrigation, municipal, industrial)

WELL COMPLETION DATA:

- (1) diameter (inches) 2"
- (2) total depth (feet) 306'
- (3) static water level (feet) 10' below top of ground.
- (4) casing Galv. pipe, 296' (material) (depth)  
 2" (size) if telescope see back.
- (5) screen 10' length, 296' (depth to top)  
 2" BRONZE (size) (material)
- (6) pump 1 (HP), 400 gpm (yield gpm)  
 Electric (type power)
- (7) electric log NO (yes or no)  
 NO (organization running log)
- (8) how well bottom plugged BACK WASH VALVE

# CODED

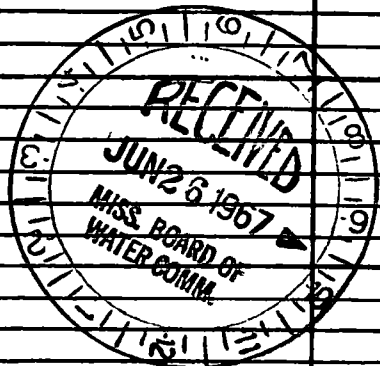

DRILLERS REMARKS:

If well telescopes please sketch and show depths.

GROUND LEVEL

		34	
		X	

SECTION 34

Please indicate well location X.

ADDITIONAL INFORMATION

Turn right at Macon's  
Grocery - Turn left  
first black top road  
Oak Lawn Road.

If more than one screen,  
show locations of each on sketch.