

Highway 15
2 miles N Intersection
Highway 67

Harrison
H 69
6-67

MISSISSIPPI
BOARD OF WATER COMMISSIONERS
416 North State Street
Jackson, Mississippi 39201

CODED

WATER WELL DRILLERS LOG

6-26 1967 date well completed
Switzer Well Co. firm name
Harrison county well located

LANDOWNER: J.B. Youngblood
208 Randall Drive
Biloxi, Mississippi
(mailing address)

description of formations encountered	from	to
clay	0	15
sand	15	23
clay	23	207
clay + sand streaks	207	226
clay	226	256
sand	256	266
clay	266	311
clay + sand streaks	311	331
clay	331	349
sand	349	356
clay	356	412
clay + sand streaks	412	432
sand	432	450
clay	450	452
fine sand	452	471
sand	471	475
clay	475	486
sand	486	490
clay	490	558
sand	558	574
clay	574	590
sand	590	598
clay + sand streaks	598	620
fine sand	620	630
good sand	630	684


WELL LOCATION:
sec 32 T 6 S R 9 E
8 miles N of Biloxi
(distance) (direction) (nearest town)

WELL PURPOSE: Home
(home, irrigation, municipal, industrial)

WELL COMPLETION DATA:

- (1) diameter (inches) 2
- (2) total depth (feet) 685
- (3) static water level (feet) 22 below top of ground.
- (4) casing gal. steel 1.75' (material) (depth)
2" (size) if telescope see back.
- (5) screen 10' (length) 675' (depth to top)
10ga. stainless steel (size) (material)
- (6) pump not installed (HP) (yield gpm)
(type power)
- (7) electric log No (yes or no)
(organization running log)
- (8) how well bottom plugged Back pressure valve

DRILLERS REMARKS:

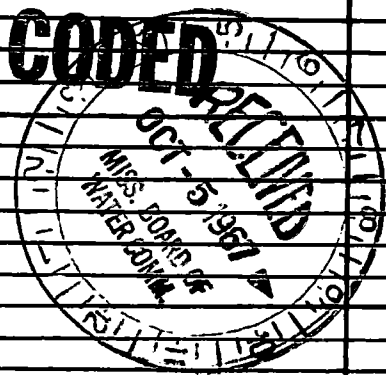

If well telescopes please sketch and show depths.

GROUND LEVEL

X			

SECTION 32

Please indicate well location X.

ADDITIONAL INFORMATION

If more than one screen, show locations of each on sketch.