

Harrison
H 71
8-67

MISSISSIPPI
BOARD OF WATER COMMISSIONERS
416 North State Street
Jackson, Mississippi 39201

CODED

WATER WELL DRILLERS LOG

8-18 1967 date well completed
Levitzes Well Co. firm name
Harrison county well located


LANDOWNER:	Description of formations encountered	from	to
Howard Delancey	Clay	0	10
Route 1	sand	10	34
Saucier, Miss	clay	34	53
(mailing address)	clay	53	63
WELL LOCATION:	clay	63	185
sec. 14 T 6 S R 10 W	mixed	185	205
30 miles N of BILLOXI	clay	205	267
(distance) (direction) (nearest town)	mixed	267	288
WELL PURPOSE:	sand	288	293
(home, irrigation, municipal, industrial)	Clay	293	308
Home	mixed	308	347
WELL COMPLETION DATA:	sand	347	355
(1) diameter (inches) 2	mixed	355	395
(2) total depth (feet) 653	sand	395	416
(3) static water level (feet) 81 below top of ground.	mixed	416	436
(4) casing gal. steel 643' (material) (depth)	sand	436	442
2" (size) If telescope see back.	mixed	442	458
(5) screen 10' (length) 643' (depth to top)	sand	458	463
3ga, ss on pipe (size) (material)	mixed	463	478
(6) pump 1 (HP) 7 (yield gpm)	clay	478	565
electric (type power)	good sand	565	653
(7) electric log No (yes or no)			
(organization running log)			
(8) how well bottom plugged Back pressure valve			
DRILLERS REMARKS:			

CODED



If well telescopes please sketch and show depths.

GROUND LEVEL

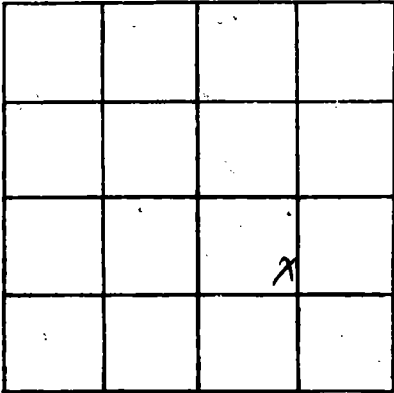

SECTION 14

Please indicate well location X.

ADDITIONAL INFORMATION

A series of horizontal lines for writing additional information, starting below the 'ADDITIONAL INFORMATION' header and extending to the bottom of the page.

If more than one screen, show locations of each on sketch.